

DISCLAIMER

The details like name of project, name of fabricator, etc. are indicative only. These should never be referred for any WPSS related matters. Only the technical details should be referred and followed for the WPSS purpose.

Model WPSS for
Railway OPEN WEB GIRDER
(25t Loading)

Railway Open Web Girder (25t loading)
91.4m clear span

MODEL WPSS No- RDSO/ Infra-II/ B&S/ RG/
OWG./ WPSS 91.4 series (43 nos)

91.4M OWG (25T LOADING)

Welding Procedure Specification Sheet (WPSS)

Name and Address of Fabricator

M/s M.G. Contractors Pvt. Ltd.,
Vill- Gola, Kalpi-Naraingarh Road,
Opposite E-max Education City,
Mullana, Ambala (HR) 133104
MGCP/20-21/DFCCIL/SSM-RFO/91.4M/SAW/WPSS-01

Welding procedure specification No.

1. Drawing No.

RDSO/B-17184 (L0-L1-L2)
DETAILS OF BOTTOM CHORD

2. Weld joint description

WEB(16 MM) WITH FLANGE (12MM) FILLET WELD (8MM)

3. Base metal

IS:2062 : 2011 E 350 Quality -B0

4. Welding process

Submerged Arc Welding (SAW)

5. Welding position

Flat (1F)

6. Welding consumables

6.1 Electrode/wire – Electrode

Class: W2 of IRS M.39

Type: Copper coated solid wire

Dia: 4.0 mm (copper coated)

Drying Method: N.A

6.2 Flux

Class: F2 of IRS M.39

Type: Agglomerated

Drying Method: 250° C to 300° C for two hour before use.

6.3 Shielding gas


N.A

7.0 Base metal preparation

Fusion faces and adjacent surfaces are cleaned and made free from cracks, notches, mill scale, grease, paint, rust etc., which might affect weld quality.

7.1 Joint design details

Sketch showing arrangements of parts, weld groove details, weld passes & their sequence etc.

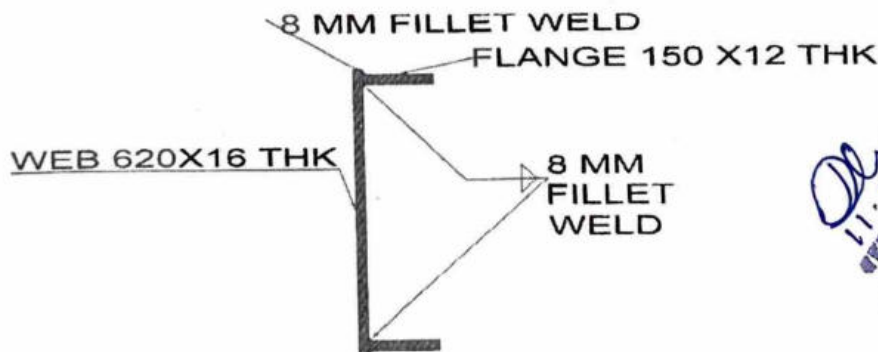

7.2 Joint preparation

As per IS 4353- 1995, Cl. 7, IRS B1 – 2001, Cl. 17.3, & WBC - 2001

8. Welding current

Type: DC
Polarity: Reverse



11-06-21
Assistant Research Officer (Moy)
Research Officer (Moy)

91.4M OWG (25T LOADING)

Welding Procedure Specification Sheet (WPSS)

Name and Address of Fabricator

M/s M.G. Contractors Pvt. Ltd.,
Vill- Gola, Kalpi-Naraingarh Road,
Opposite E-max Education City,
Mullana, Ambala (HR) 133104
MGCPL/20-21/DFCCIL/SSM-RFO/91.4M/SAW/WPSS-

Welding procedure specification No.
02

1. Drawing No.

RDSO/B-17184 (L2-L3-L4)
DETAILS OF BOTTOM CHORD

2. Weld joint description

WEB(20 MM) WITH FLANGE (16MM) FILLET WELD (8MM)
WEB (20MM) WITH ADDITIONAL (16MM) PLATE (8 MM)
IS:2062 : 2011 E 350 Quality -B0

3. Base metal

Submerged Arc Welding (SAW)

4. Welding process

Flat

5. Welding position

6. Welding consumables

6.1 Electrode/wire - Electrode

Class: W2 of IRS M.39
Type: Copper coated solid wire
Dia: 4.0 mm (copper coated)

Drying Method: N.A

6.2 Flux

Class: F2 of IRS M.39

Type: Agglomerated

Drying Method: 250° C to 300° C for two hour before use.

6.3 Shielding gas


N.A

7.0 Base metal preparation

Fusion faces and adjacent surfaces are cleaned and made free from cracks, notches, mill scale, grease, paint, rust etc., which might affect weld quality.

7.1 Joint design details

Sketch showing arrangements of parts, weld groove details, weld passes & their sequence etc.

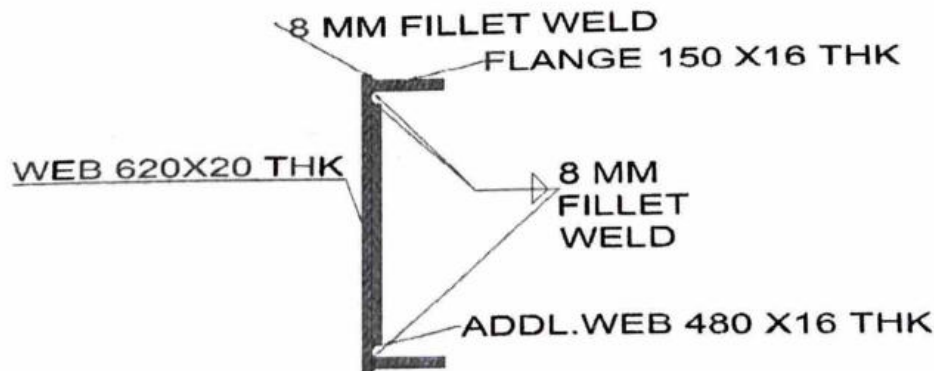

7.2 Joint preparation

As per IS 4353- 1995, Cl. 7, IRS B1 - 2001, Cl. 17.3, & WBC - 2001




7/16

91.4M OWG (25T LOADING)

8. Welding current : Type : DC
Polarity: Reverse
9. Welder qualification : First welder as per IS-7307(Part-I) First welder at all test then other welder As per IS 7310 (Part I) – 1974
10. Welding parameters and technique :
- 10.1 Welding parameter :

Weld Pass		Electrodes/ Wire dia. (mm)	Current Amp.	Arc Voltage (volt)	Wire feed Speed (m/min)	Travel Speed (m/min)	Electrode Stick out (mm)	Gas flow (l/min)
Front side	Back Side							
single	single	4	450-550	28-30	controlled by current	0.45-0.50	15-20	N.A

- 10.2 Welding sequence :

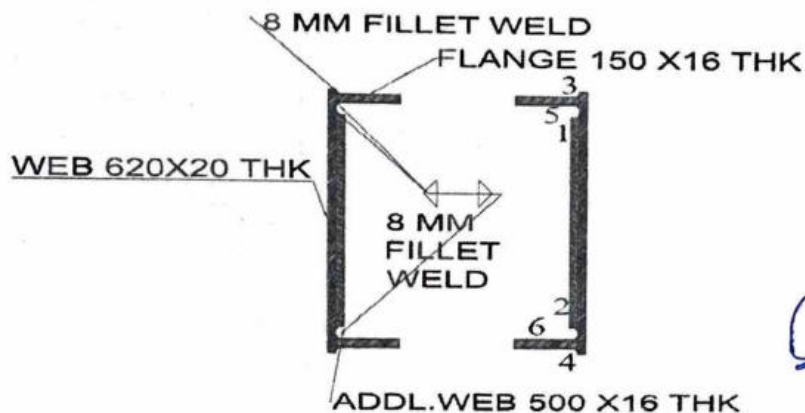

11. Provision of running & run off tabs : Yes
12. Cleaning of weld bead before laying next weld bead : N.A.
13. Root preparation before welding other side of groove weld : N.A.
14. Preheating & interpass temperature : Min-150°C , Interpass Max- 250°C
15. Peening : N.A.
16. Post weld treatment : N.A.
17. Rectification of weld defects : By grinding of the defective weld & rectifying the weld as per Cl 32.2 of IS 9595-96, using A3 class of electrodes of specn IRS M.28-12 after conducting D P test.
18. Inspection of weld : Visually, D.P.Test & Macro Etching

11.06.21

अनुसंधान अधिकारी (मेट)
Assistant Research Officer (Met.)
रेल्वे मंत्रालय, नई दिल्ली-110001

2/17

91.4M OWG (25T LOADING)

Welding Procedure Specification Sheet (WPSS)

Name and Address of Fabricator

: M/s M.G. Contractors Pvt. Ltd.,
Vill- Gola, Kalpi-Naraingarh Road,
Opposite E-max Education City,
Mullana, Ambala (HR) 133104
MGCPL/20-21/DFCCIL/SSM-RFO/91.4M/SAW/WPSS-03

Welding procedure specification No.

1. Drawing No.

: RDSO/B-17184 (L4-L5-L6)
DETAILS OF BOTTOM CHORD

2. Weld joint description

: WEB(25 MM) WITH FLANGE (20 MM) FILLET WELD (8MM)
WEB(25 MM) WITH ADD.(16 MM) FILLET WELD (8 MM)

3. Base metal

: IS:2062 : 2011 E 350 Quality B0

4. Welding process

: Submerged Arc Welding (SAW)

5. Welding position

: Flat

6. Welding consumables

6.1 Electrode/wire – Electrode

: Class: W2 of IRS M.39
Type: Copper coated solid wire
Dia: 4.0 mm (copper coated)
Drying Method: N.A

6.2 Flux

: Class: F2 of IRS M.39
Type: Agglomerated
Drying Method: 250° C to 300° C for two hour before use.

6.3 Shielding gas


: N.A

7.0 Base metal preparation

: Fusion faces and adjacent surfaces are cleaned and made free from cracks, notches, mill scale, grease, paint, rust etc., which might affect weld quality.

7.1 Joint design details

: Sketch showing arrangements of parts, weld groove details, weld passes & their sequence etc.

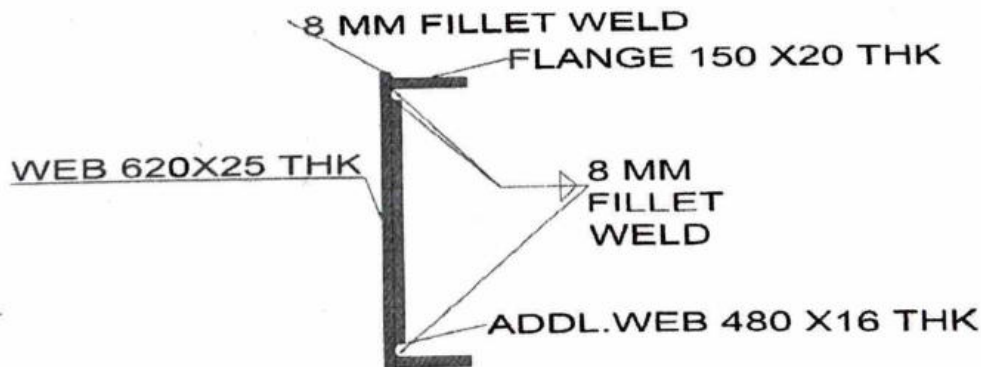

7.2 Joint preparation

: As per IS 4353- 1995, Cl. 7, IRS B1 – 2001, Cl. 17.3, & WBC - 2001

Signature
11.06.21
Assistant Research Officer (Met)
RDSO, Kalpi, Ambala


Substant Private

91.4M OWG (25T LOADING)

8. Welding current : Type : DC
Polarity: Reverse
9. Welder qualification : First welder as per IS-7307(part-I) First welder at all test then other welder As per IS 7310 (Part I) - 1974
10. Welding parameters and technique :
- 10.1 Welding parameter :

Weld Pass		Electrodes/ Wire dia. (mm)	Current Amp.	Arc Voltage (volt)	Wire feed Speed (m/min)	Travel Speed (m/min)	Electrode Stick out (mm)	Gas flow (l/min)
Front side single	Back Side single							
		4	450-500	28-30	controlled by current	0.45-0.50	15-20	N.A

10.2 Welding sequence

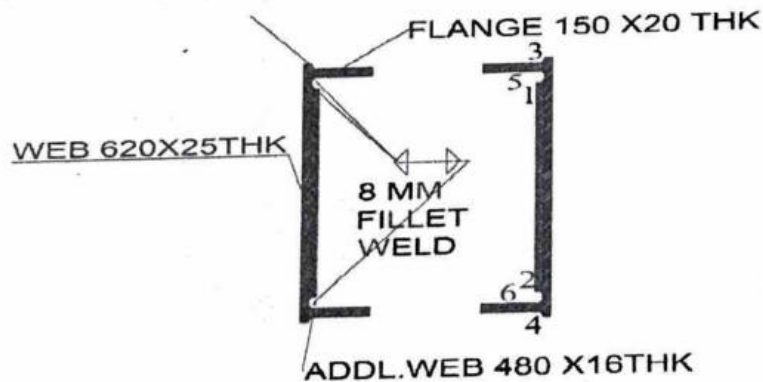

Signature
11.06.2019 (Date)
Assistant Research Officer (Met)
प्राथमिक प्रयोगशाला, दिल्ली

11. Provision of running & run off tabs : Yes
12. Cleaning of weld bead before laying next weld bead : N.A.
13. Root preparation before welding other side of groove weld : N.A.
14. Preheating & interpass temperature : Min-150°C , Interpass Max- 250°C
15. Peening : N.A
16. Post weld treatment : N.A.
17. Rectification of weld defects : By grinding of the defective weld & rectifying the weld as per CI 32.2 of IS 9595-96, using A3 class of electrodes of specn IRS M.28-12 after conducting D P test.
18. Inspection of weld : Visually, D.P.Test & Macro Etching

7/19

91.4M OWG (25T LOADING)

Welding Procedure Specification Sheet (WPSS)

Name and Address of Fabricator

M/s M.G. Contractors Pvt. Ltd.,
Vill- Gola, Kalpi-Naraingarh Road,
Opposite E-max Education City,
Mullana, Ambala (HR) 133104
MGCP/20-21/DFCCIL/SSM-RFO/91.4M/SAW/WPSS-03A

Welding procedure specification No.

RDSO/B-17184 (L6-L7)
DETAILS OF BOTTOM CHORD

1. Drawing No.

2. Weld joint description

3. Base metal

4. Welding process

5. Welding position

6. Welding consumables

6.1 Electrode/wire – Electrode

WEB(25 MM) WITH FLANGE (25 MM) FILLET WELD (8MM)
WEB(25 MM) WITH ADD.(25 MM) FILLET WELD (8 MM)
IS.2062 : 2011 E 350 Quality B0
Submerged Arc Welding (SAW)
Flat

Class: W2 of IRS M.39
Type: Copper coated solid wire
Dia: 4.0 mm (copper coated)

Drying Method: N.A

6.2 Flux

Class: F2 of IRS M.39

Type: Agglomerated

Drying Method: 250° C to 300° C for two hour before use.

6.3 Shielding gas


N.A

7.0 Base metal preparation

Fusion faces and adjacent surfaces are cleaned and made free from cracks, notches, mill scale, grease, paint, rust etc., which might affect weld quality.

7.1 Joint design details

Sketch showing arrangements of parts, weld groove details, weld passes & their sequence etc.

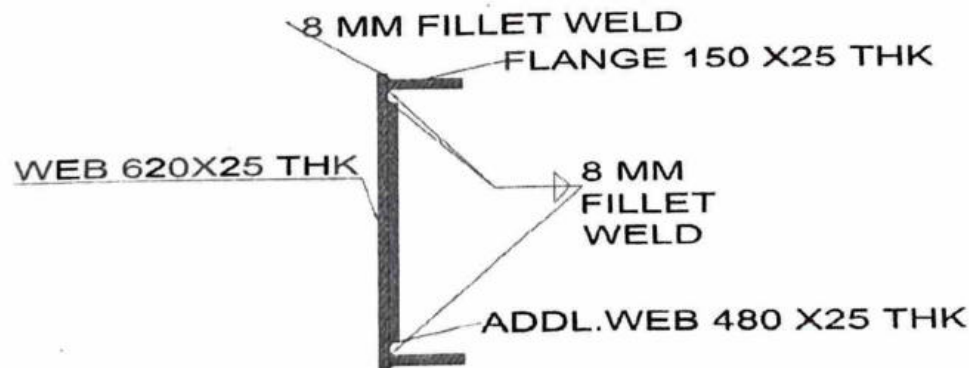

7.2 Joint preparation

As per IS 4353- 1995, Cl. 7, IRS B1 – 2001, Cl. 17.3. & WBC - 2001




2/19

91.4M OWG (25T LOADING)

Welding Procedure Specification Sheet (WPSS)

Name and Address of Fabricator	M/s M.G. Contractors Pvt. Ltd., Vill- Gola, Kalpi-Naraingarh Road, Opposite E-max Education City, Mullana, Ambala (HR) 133104
Welding procedure specification No.	MGCPL/20-21/DFCCIL/SSM-RFO/91.4M/SAW/WPSS-03A
1. Drawing No.	RDSO/B-17184 (L6-L7) DETAILS OF BOTTOM CHORD
2. Weld joint description	WEB(25 MM) WITH FLANGE (25 MM) FILLET WELD (8MM) WEB(25 MM) WITH ADD.(25 MM) FILLET WELD (8 MM)
3. Base metal	IS:2062 : 2011 E 350 Quality B0
4. Welding process	Submerged Arc Welding (SAW)
5. Welding position	Flat
6. Welding consumables	
6.1 Electrode/wire – Electrode	Class: W2 of IRS M.39 Type: Copper coated solid wire Dia: 4.0 mm (copper coated) Drying Method: N.A
6.2 Flux	Class: F2of IRS M.39 Type: Agglomerated Drying Method: 250° C to 300° C for two hour before use.
6.3 Shielding gas	N.A
7.0 Base metal preparation	Fusion faces and adjacent surfaces are cleaned and made free from cracks, notches, mill scale, grease, paint, rust etc., which might affect weld quality.
7.1 Joint design details	Sketch showing arrangements of parts, weld groove details, weld passes & their sequence etc.

11.06.21
Assistant Research Officer (Met)
आसिस्टन्ट रिसर्च ऑफिसर (मेट)

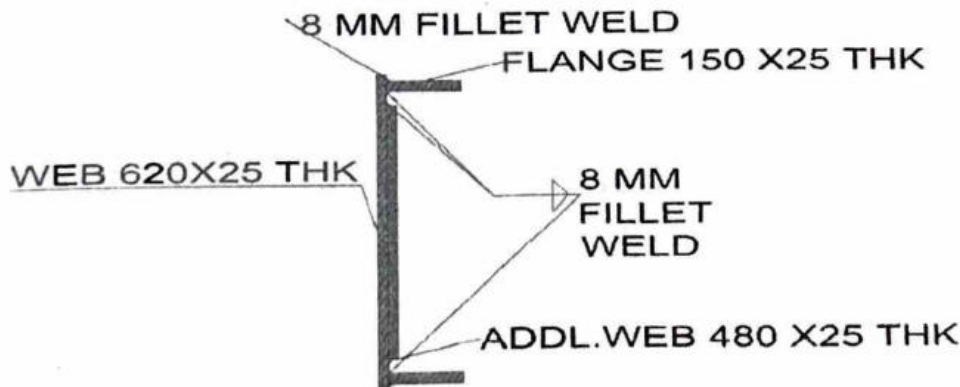

7.2 Joint preparation


As per IS 4363- 1995, Cl. 7, IRS B1 – 2001, Cl. 17.3. & WBC - 2001

91.4M OWG (25T LOADING)

8. Welding current : Type : DC
Polarity: Reverse
9. Welder qualification : First welder as per IS-7307(part-I) First welder at all test then other welder As per IS 7310 (Part I) – 1974
10. Welding parameters and technique :
- 10.1 Welding parameter :

Weld Pass		Electrodes/ Wire dia. (mm)	Current Amp.	Arc Voltage (volt)	Wire feed Speed (m/min)	Travel Speed (m/min)	Electrode Stick out (mm)	Gas flow (l/min)
Front side	Back Side							
single	single	4	450-550	28-30	controlled by current	0.45-0.50	15-20	N.A

- 10.2 Welding sequence :

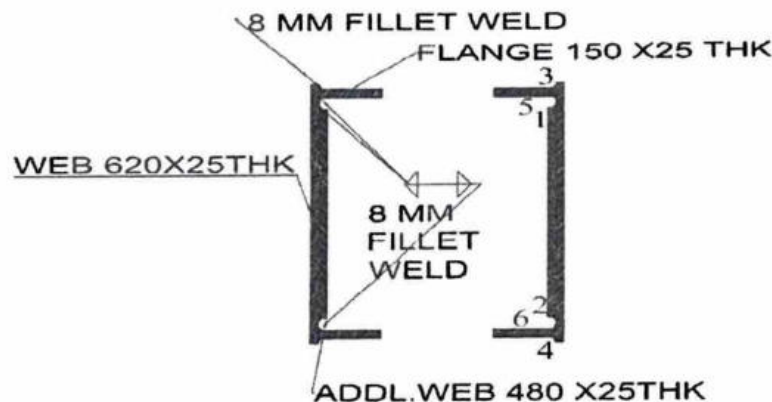

11. Provision of running & run off tabs : Yes
12. Cleaning of weld bead before laying next weld bead : N.A.
13. Root preparation before welding other side of groove weld : N.A.
14. Preheating & interpass temperature : Min-150°C , Interpass Max- 250°C
15. Peening : N.A
16. Post weld treatment : N.A
17. Rectification of weld defects : By grinding of the defective weld & rectifying the weld as per CI 32.2 of IS 9595-96, using A3 class of electrodes of specn IRS M.28-12 after conducting D P test.
18. Inspection of weld : Visually, D.P.Test & Macro Etching


Signature
11.06.2020
अनुसंधान अधिकारी (मेट)
Assistant Research Officer (Met)
रेल्व मंत्रालय, बलसहर-11


7/21

91.4M OWG (25T LOADING)

Welding Procedure Specification Sheet (WPSS)

Name and Address of Fabricator	M/s M.G. Contractors Pvt. Ltd., Vill- Gola, Kalpi-Naraingarh Road, Opposite E-max Education City, Mullana, Ambala (HR) 133104
Welding procedure specification No.	MGCPL/20-21/DFCCIL/SSM-RFO/91.4M/SAW/WPSS-04
1. Drawing No.	: RDSO/B-17184 (U0-U1-U2) DETAILS OF TOP CHORD
2. Weld joint description	: WEB (10MM) WITH FLANGE (16MM) FILLET WELD (8MM) WEB(10 MM) WITH TOP PLATE(12MM) OUTER SIDE (8MM)
3. Base metal	: IS:2062 : 2011 E 350 Quality-B0
4. Welding process	: Submerged Arc Welding (SAW)
5. Welding position	: Flat
6. Welding consumables	
6.1 Electrode/wire – Electrode	: Class: W2 of IRS M.39 Type: Copper coated solid wire Dia: 4.0 mm (copper coated)
6.2 Flux	: Drying Method: N.A Class: F2 of IRS M.39 Type: Agglomerated Drying Method: 250° C to 300° C for two hour before use.
6.3 Shielding gas	: N.A
7.0 Base metal preparation	: Fusion faces and adjacent surfaces are cleaned and made free from cracks, notches, mill scale, grease, paint, rust etc., which might affect weld quality.
7.1 Joint design details	: Sketch showing arrangements of parts, weld groove details, weld passes & their sequence etc.


 11.06.21
 अनुसंधान अधिकारी (मृत्तु)
 Assistant Research Officer (Met)
 भारतीय रेलवे प्रयोगशाला, दिल्ली

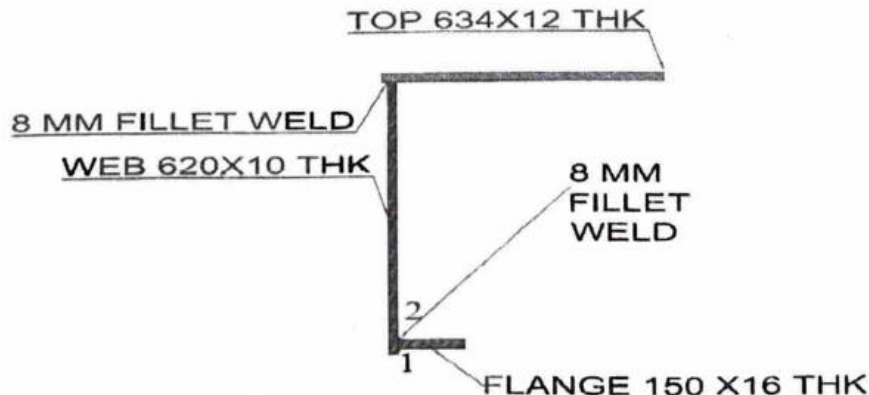

7.2 Joint preparation

: As per IS 4353- 1995, Cl. 7, IRS B1 – 2001, Cl. 17.3, & WBC - 2001




7/22

91.4M OWG (25T LOADING)

8. Welding current : Type : DC
Polarity: Reverse
9. Welder qualification : First welder as per IS-7307(part-I) First welder at all test then other welder As per IS 7310 (Part I) - 1974
10. Welding parameters and technique :
- 10.1 Welding parameter :

Weld Pass		Electrodes/ Wire dia. (mm)	Current Amp.	Arc Voltage (volt)	Wire feed Speed (m/min)	Travel Speed (m/min)	Electrode Stick out (mm)	Gas flow (l/min)
Front side single	Back Side single	4	450-550	28-30	controlled by current	0.45-0.50	15-20	N.A

- 10.2 Welding sequence :

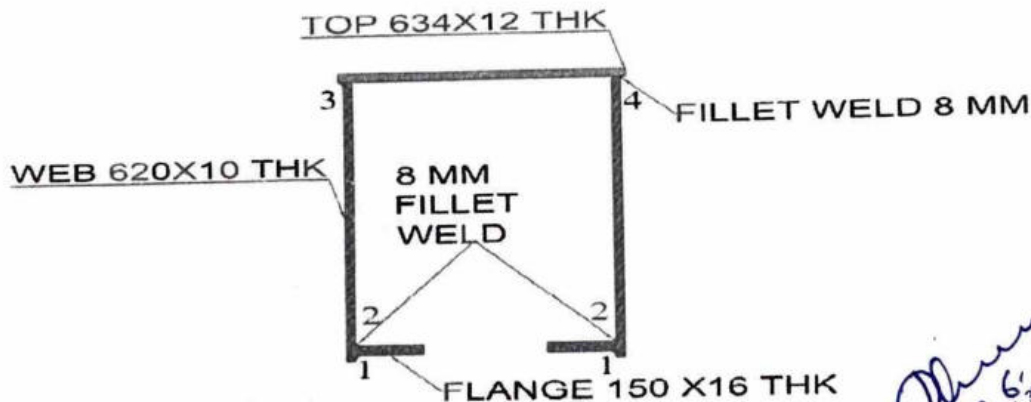

11. Provision of running & run off tabs : yes
12. Cleaning of weld bead before laying next weld bead : N.A.
13. Root preparation before welding other side of groove weld : N.A.
14. Preheating & interpass temperature : Min-150°C , Interpass Max- 250°C
15. Peening : N.A
16. Post weld treatment : N.A.
17. Rectification of weld defects : By grinding of the defective weld & rectifying the weld as per CI 32.2 of IS 9595-96, using A3 class of electrodes of specn IRS M.28-12 after conducting D P test.
18. Inspection of weld : Visually, D.P.Test & Macro Etching

Signature
11.06.21 (Date)
आसिस्टेंट अनुसंधान अधिकारी (मेट),
Assistant Research Officer (Met),
राजस्थान राज्य प्रशासनिक प्रणाली-1)

7/23

91.4M OWG (25T LOADING)


Welding Procedure Specification Sheet (WPSS)

Name and Address of Fabricator : M/s M.G Contractors Pvt. Ltd.,
VIII- Gola, Kalpi-Naraingarh Road,
Opposite E-max Education City,
Mullana, Ambala (HR) 133104

Welding procedure specification No. MGCPL/20-21/DFCCIL/SSM-RFO/91.4M/GMAW/WPSS-05

1. Drawing No. : RDSO/B-17184 (U2-U3-U4)
DETAILS OF TOP CHORD
2. Weld joint description : WEB(10 MM) WITH TOP PLATE (12MM) INNER SIDE (8MM)
3. Base metal : IS.2062 : 2011 E 350 Quality B0
4. Welding process : GMAW
5. Welding position : horizontal
6. Welding consumables :
 - 6.1 Electrode/wire – Electrode : Class: Class 1 of IRS M.46
Type: Copper coated solid wire
Dia: 1.2 mm (copper coated)
Drying Method: N.A.
 - 6.2 Flux : Class: N.A.
Type: N A
Drying Method: N.A.
 - 6.3 Shielding gas : CO₂
 - 7.0 Base metal preparation : Fusion faces and adjacent surfaces are cleaned and made free from cracks, notches, mill scale, grease, paint, rust etc., which might affect weld quality.
 - 7.1 Joint design details : Sketch showing arrangements of parts, weld details, weld passes & their sequence etc.

[Handwritten Signature]
11.06.2021 (Met)
Assistant Research Officer (Met)
DRD, Ambala

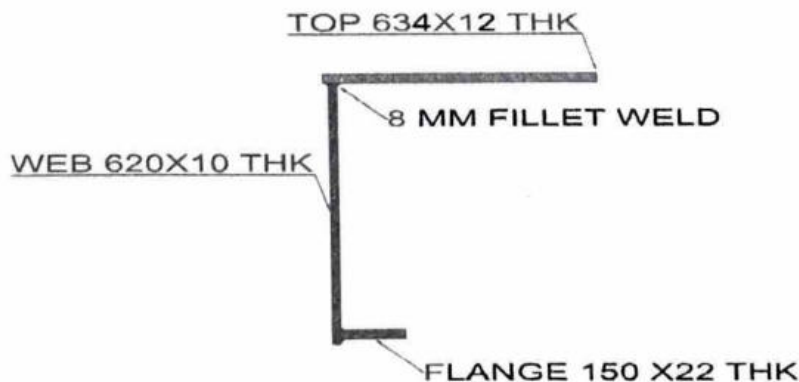

- 7.2 Joint preparation : As per IS 10178, Cl. 7, IRS B1 – 2001, Cl 17.3, & WBC - 2001
8. Welding current : Type : DC
Polarity: Reverse




7/27

91.4M OWG (25T LOADING)

9. Welder qualification : First welder as per IS-7307(part-I) First welder at all test then other welder As per IS 7310 (Part I) – 1974
10. Welding parameters and technique :
- 10.1 Welding parameter :

Weld Pass		Electrodes/ Wire dia. (mm)	Current Amp.	Arc Voltage (volt)	Wire feed Speed (m/min)	Travel Speed (m/min)	Electrode Stick out (mm)	Gas flow (l/min)
Front side	Back Side							
	single	1.2	180-220	22-26	Controlled by current	N.A.	12-15	15-18

- 10.2 Welding sequence :

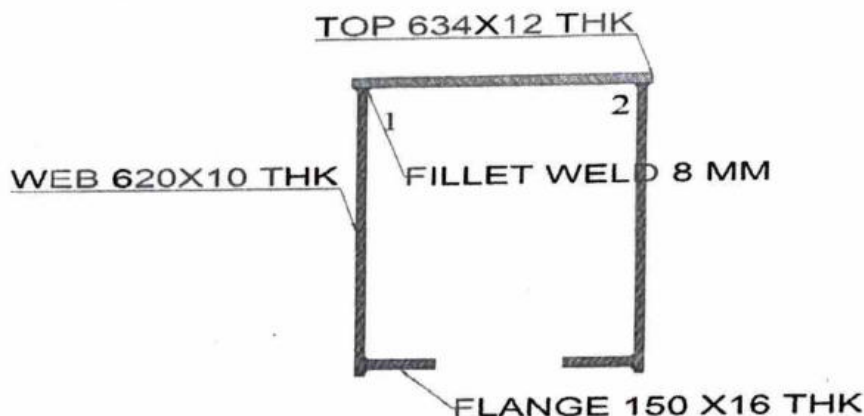

11. Provision of running & run off tabs : yes
12. Cleaning of weld bead before laying next weld bead : N.A.
13. Root preparation before welding other side of groove weld : N.A.
14. Preheating & interpass temperature : Min-75°C , Interpass Max- 250°C
15. Peening : N.A.
16. Post weld treatment : N.A.
17. Rectification of weld defects : By grinding of the defective weld & rectifying the weld as per Cl 32.2 of IS 9595-96, using A3 class of electrodes of specn IRS M 28-12 after conducting D P test.
18. Inspection of weld : Visually, D.P.Test & Macro Etching

11.06.21
 Assistant Research Officer (Met.)
 Research Officer (Met.)
 Research Officer (Met.)

91.4M OWG (25T LOADING)

Welding Procedure Specification Sheet (WPSS)

Name and Address of Fabricator

M/s M.G. Contractors Pvt. Ltd.,
Vill- Gola, Kalpi-Naraingarh Road,
Opposite E-max Education City,
Mullana, Ambala (HR) 133104
MGCP/20-21/DFCCIL/SSM-RFO/91.4M/SAW/WPSS-06

Welding procedure specification No.

RDSO/B-17184 (U2-U3-U4)
DETAILS OF TOP CHORD

1. Drawing No.

2. Weld joint description

3. Base metal

4. Welding process

5. Welding position

6. Welding consumables

6.1 Electrode/wire – Electrode

WEB (20 MM) WITH FLANGE (16MM) FILLET WELD (8MM)
WEB(20 MM) WITH TOP PLATE(16MM) OUTER SIDE (8MM)
IS:2062 : 2011 E 350 Quality B0

Submerged Arc Welding (SAW)

Flat

Class: W2 of IRS M.39
Type: Copper coated solid wire
Dia: 4.0 mm (copper coated)

Drying Method: N.A

6.2 Flux

Class: F2 of IRS M.39

Type: Agglomerated

Drying Method: 250° C to 300° C for two hour before use.

6.3 Shielding gas


N.A

7.0 Base metal preparation

Fusion faces and adjacent surfaces are cleaned and made free from cracks, notches, mill scale, grease, paint, rust etc., which might affect weld quality.

7.1 Joint design details

Sketch showing arrangements of parts, weld groove details, weld passes & their sequence etc.

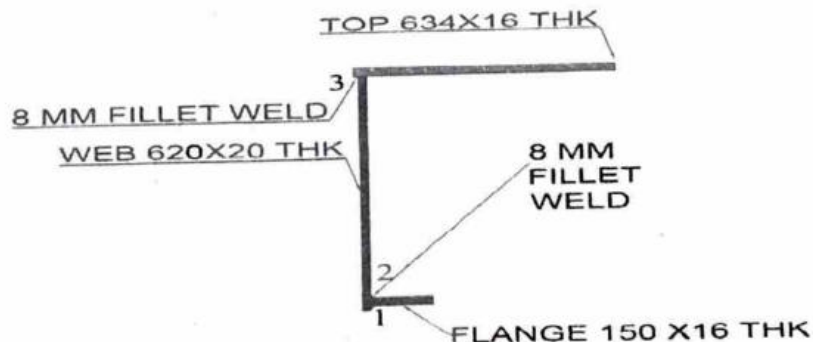

7.2 Joint preparation

As per IS 4353- 1995, Cl. 7, IRS B1 – 2001, Cl. 17.3, & WBC - 2001

8. Welding current


Type: DC
Polarity: Reverse

91.4M OWG (25T LOADING)

9. Welder qualification : First welder as per IS-7307 (part-I) First welder at all test then other welder As per IS 7310 (Part I) – 1974
10. Welding parameters and technique :
- 10.1 Welding parameter :

Weld Pass		Electrodes/ Wire dia. (mm)	Current Amp.	Arc Voltage (volt)	Wire feed Speed (m/min)	Travel Speed (m/min)	Electrode Stick out (mm)	Gas flow (l/min)
Front side	Back Side							
single	single	4	450-550	28-30	controlled by current	0.45-0.50	15-20	N.A

- 10.2 Welding sequence :

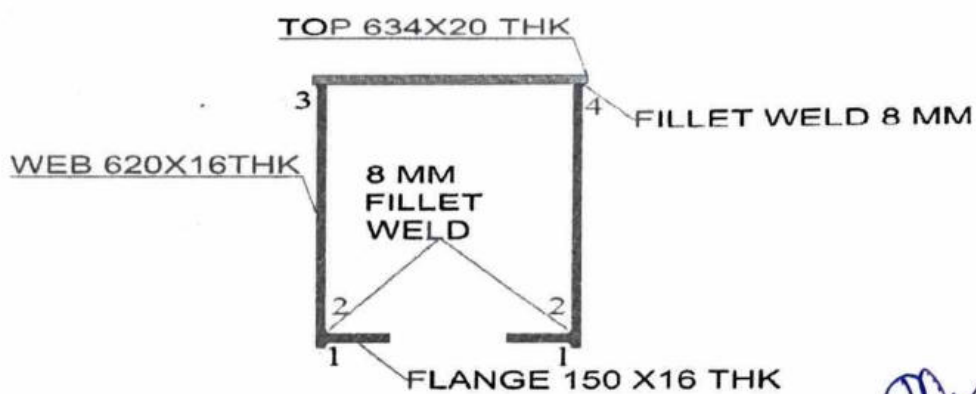

11. Provision of running & run off tabs : Yes
12. Cleaning of weld bead before laying next weld bead : N.A.
13. Root preparation before welding other side of groove weld : N.A.
14. Preheating & interpass temperature : Min-150°C , Interpass Max- 250°C
15. Peening : N.A
16. Post weld treatment : N.A.
17. Rectification of weld defects : By grinding of the defective weld & rectifying the weld as per CI 32.2 of IS 9595-96, using A3 class of electrodes of specn IRS M.28-12 after conducting D P test.
18. Inspection of weld : Visually, D.P.Test & Macro Etching


11.06.21
 Assistant Research Officer (Met)
 ११.०६.२१
 ११.०६.२१

91.4M OWG (25T LOADING)

Welding Procedure Specification Sheet (WPSS)

Name and Address of Fabricator : M/s M.G. Contractors Pvt. Ltd.,
Vill- Gola, Kalpi-Naraingarh Road,
Opposite E-max Education City,
Mullana, Ambala (HR) 133104
Welding procedure specification No. : MGCP/20-21/DFCCIL/SSM-RFO/91.4M/GMAW/WPSS-07

1. Drawing No. : RDSO/B-17184 (U2-U3-U4)
DETAILS OF TOP CHORD
2. Weld joint description : WEB(20 MM) WITH TOP PLATE(16MM) INNER SIDE (8MM)
3. Base metal : IS:2062 : 2011 E 350 Quality- B0
4. Welding process : GMAW
5. Welding position : horizontal
6. Welding consumables :
6.1 Electrode/wire – Electrode : Class: Class 1 of IRS M.46
Type: Copper coated solid wire
Dia: 1.2 mm (copper coated)
Drying Method: N.A.
- 6.2 Flux : Class: N.A.
Type: N.A.
Drying Method: N.A.
- 6.3 Shielding gas : CO₂
- 7.0 Base metal preparation : Fusion faces and adjacent surfaces are cleaned and made free from cracks, notches, mill scale, grease, paint, rust etc., which might affect weld quality.
- 7.1 Joint design details : Sketch showing arrangements of parts, weld details, weld passes & their sequence etc.

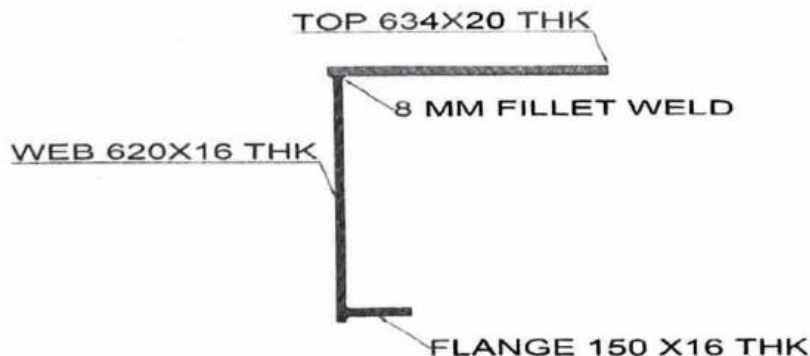

- 7.2 Joint preparation : As per IS 10178, Cl. 7, IRS B1 – 2001, Cl. 17.3, & WBC - 2001
8. Welding current : Type: DC
Polarity: Reverse
9. Welder qualification : First Welder as per IS-7307(part-I) First welder at all test then other welder As per IS 7310 (Part I) – 1974




91.4M OWG (25T LOADING)

10. Welding parameters and technique :

10.1 Welding parameter :

Weld Pass		Electrodes/ Wire dia. (mm)	Current Amp.	Arc Voltage (volt)	Wire feed Speed (m/min)	Travel Speed (m/min)	Electrode Stick out (mm)	Gas flow (l/min)
Front side	Back Side							
	single	1.2	180-220	22-26	Controlled by Current	N.A.	12-15	15-18

10.2 Welding sequence :

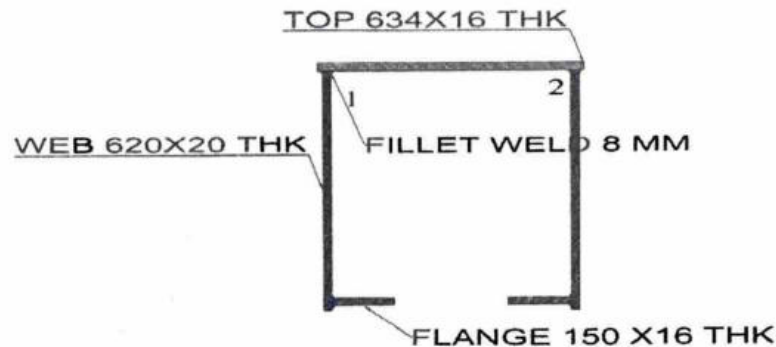

11. Provision of running & run off tabs : Yes

12. Cleaning of weld bead before laying next weld bead : N.A.

13. Root preparation before welding other side of groove weld : N.A.

14. Preheating & interpass temperature : Min-75°C , Interpass Max- 250°C

15. Peening : N.A

16. Post weld treatment : N.A.

17. Rectification of weld defects : By grinding of the defective weld & rectifying the weld as per Cl 32.2 of IS 9595-96, using A3 class of electrodes of specn IRS M 28-12 after conducting D P test.

18. Inspection of weld : Visually, D.P.Test & Macro Etching

Signature
11.06.21
शुभाषक अनुसंधान अधिकारी (धातु)
Assistant Research Officer (Met.)
राज्य न्यायालय, बल्लार-11

91.4M OWG (25T LOADING)

Welding Procedure Specification Sheet (WPSS)

Name and Address of Fabricator

M/s M.G. Contractors Pvt. Ltd.,
Vill- Gola, Kalpi-Naraingarh Road,
Opposite E-max Education City,
Mullana, Ambala (HR) 133104
MGCPL/20-21/DFCCIL/SSM-RFO/91.4M/SAW/WPSS-08

Welding procedure specification No.

1. Drawing No.

RDSO/B-17184 (U4-U5-U6)
DETAILS OF TOP CHORD

2. Weld joint description

WEB (32 MM) WITH FLANGE (20MM) FILLET WELD (8MM)
WEB(32 MM) WITH TOP PLATE(20MM) OUTER SIDE (8MM)
IS:2062 : 2011 E 350 Quality B0

3. Base metal

Submerged Arc Welding (SAW)

4. Welding process

Flat

5. Welding position

6. Welding consumables

6.1 Electrode/wire – Electrode

Class: W2 of IRS M.39
Type: Copper coated solid wire
Dia: 4.0 mm (copper coated)

Drying Method: N.A

6.2 Flux

Class: F2 of IRS M.39

Type: Agglomerated

Drying Method: 250° C to 300° C for two hour before use.

6.3 Shielding gas


N.A

7.0 Base metal preparation

Fusion faces and adjacent surfaces are cleaned and made free from cracks, notches, mill scale, grease, paint, rust etc., which might affect weld quality.

7.1 Joint design details

Sketch showing arrangements of parts, weld groove details, weld passes & their sequence etc.

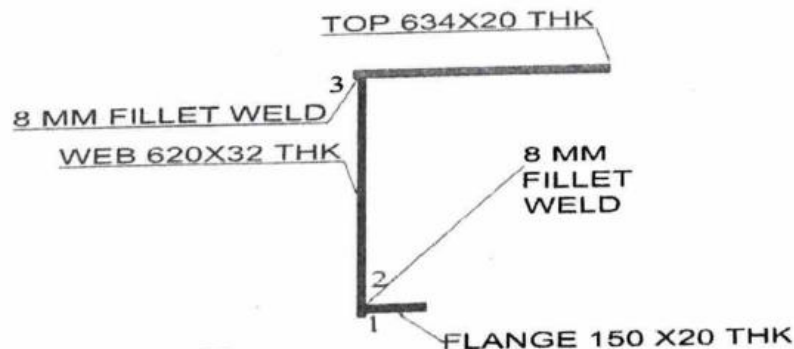

7.2 Joint preparation

As per IS 4353- 1995, Cl. 7, IRS B1 – 2001, Cl. 17.3, & WBC - 2001


7/30

91.4M OWG (25T LOADING)

8. Welding current : Type : DC
Polarity: Reverse
9. Welder qualification : First welder as per IS-7307 (part-I) First welder at all test then other welder As per IS 7310 (Part I) – 1974
10. Welding parameters and technique :
- 10.1 Welding parameter :

Weld Pass		Electrodes/ Wire dia. (mm)	Current Amp.	Arc Voltage (volt)	Wire feed Speed (m/min)	Travel Speed (m/min)	Electrode Stick out (mm)	Gas flow (l/min)
Front side	Back Side							
single	single	4	450-550	28-30	controlled by current	0.45-0.50	15-20	N.A

- 10.2 Welding sequence :

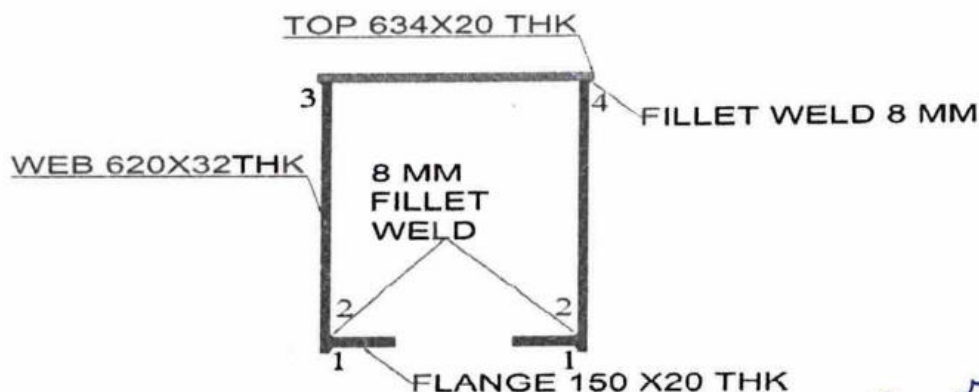

11. Provision of running & run off tabs : Yes
12. Cleaning of weld bead before laying next weld bead : N.A.
13. Root preparation before welding other side of groove weld : N.A.
14. Preheating & interpass temperature : Min-150°C , Interpass Max- 250°C
15. Peening : N.A
16. Post weld treatment : N.A.
17. Rectification of weld defects : By grinding of the defective weld & rectifying the weld as per Cl 32.2 of IS 9595-96, using A3 class of electrodes of specn IRS M.28-12 after conducting D P test.
18. Inspection of weld : Visually, D.P.Test & Macro Etching

11.06.21
 उपपक्ष अनुसंधान अधिकारी (मेटल)
 Assistant Research Officer (Met,
 एन.डी.ए. रेल मंत्रालय, बल्लार-11

7/31


91.4M OWG (25T LOADING)

Welding Procedure Specification Sheet (WPSS)

Name and Address of Fabricator : M/s M.G Contractors Pvt. Ltd.,
Vill- Gola, Kalpi-Naraingarh Road,
Opposite E-max Education City,
Mullana, Ambala (HR) 133104
Welding procedure specification No. : MGCPL/20-21/DFCCIL/SSM-RFO/91.4M/GMAW/WPSS-09

1. Drawing No. : RDSO/B-17184 (U4-U5-U6)
DETAILS OF TOP CHORD
2. Weld joint description : WEB(20 MM) WITH TOP PLATE(16MM) INNER SIDE (8MM)
3. Base metal : IS:2062 : 2011 E 350 Quality- B0
4. Welding process : GMAW
5. Welding position : horizontal
6. Welding consumables :
6.1 Electrode/wire – Electrode : Class: Class 1 of IRS M.46
Type: Copper coated solid wire
Dia: 1.2 mm (copper coated)
Drying Method: N.A.
- 6.2 Flux : Class: N.A.
Type: N.A.
Drying Method: N.A.
- 6.3 Shielding gas : CO₂
- 7.0 Base metal preparation : Fusion faces and adjacent surfaces are cleaned and made free from cracks, notches, mill scale, grease, paint, rust etc., which might affect weld quality.
- 7.1 Joint design details : Sketch showing arrangements of parts, weld details, weld passes & their sequence etc.

11.06.21

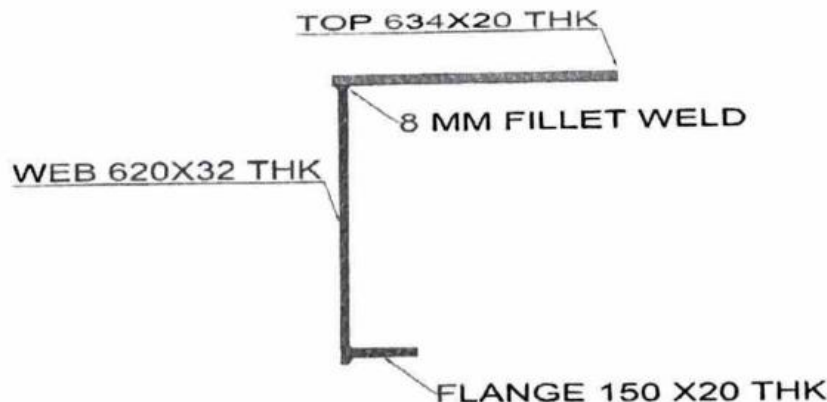

- 7.2 Joint preparation : As per IS 10178, Cl. 7, IRS B1 – 2001, Cl. 17.3, & WBC - 2001
8. Welding current : Type: DC
Polarity: Reverse
9. Welder qualification : First Welder as per IS-7307(part-I) First welder at all test



7/32

91.4M OWG (25T LOADING)


then other welder As per IS 7310 (Part I) – 1974

10. Welding parameters and technique :

10.1 Welding parameter :

Weld Pass		Electrodes/ Wire dia. (mm)	Current Amp.	Arc Voltage (volt)	Wire feed Speed (m/min)	Travel Speed (m/min)	Electrode Stick out (mm)	Gas flow (l/min)
Front side	Back Side							
	single	1.2	180-220	22-26	Controlled by Current	N.A.	12-15	15-18

10.2 Welding sequence :

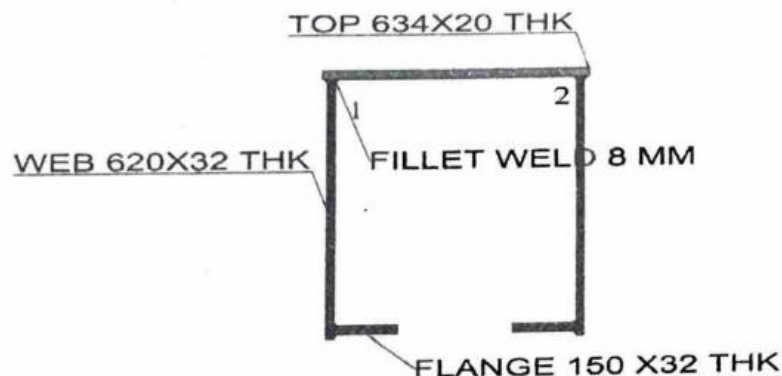

11. Provision of running & run off tabs : Yes

12. Cleaning of weld bead before laying next weld bead : N.A.

13. Root preparation before welding other side of groove weld : N.A.

14. Preheating & interpass temperature : 150°C

15. Peening : N.A.

16. Post weld treatment : N.A.

17. Rectification of weld defects : By grinding of the defective weld & rectifying the weld as per CI 32.2 of IS 9595-96, using A3 class of electrodes of specn IRS M.28-12 after conducting D P test.


18. Inspection of weld : Visually, D.P.Test & Macro Etching

Signature
11.06.27
अनुसंधान अधिकारी (संग)
Assistant Research Officer (Met)
भारतीय रेलवे अनुसंधान संस्थान

91.4M OWG (25T LOADING)

Welding Procedure Specification Sheet (WPSS)

Name and Address of Fabricator	: M/s M G Contractors Pvt. Ltd., Vill- Gola, Kalpi-Naraingarh Road, Opposite E-max Education City, Mullana, Ambala (HR) 133104 MGCPL/20-21/DFCCIL/SSM-RFO/91 4M/SAW/WPSS-10		
Welding procedure specification No.	: RDSO/B-17184 (U6-U7) DETAILS OF TOP CHORD		
1. Drawing No.	: RDSO/B-17184 (U6-U7) DETAILS OF TOP CHORD		
2. Weld joint description	: WEB (32 MM) WITH FLANGE (32MM) FILLET WELD (8MM) WEB(32 MM) WITH TOP PLATE(25MM) OUTER SIDE (8MM)		
3. Base metal	: IS:2062 : 2011 E 350 Quality B0		
4. Welding process	: Submerged Arc Welding (SAW)		
5. Welding position	: Flat		
6. Welding consumables	:		
6.1 Electrode/wire – Electrode	Class:	W2 of IRS M.39	
	Type:	Copper coated solid wire	
	Dia:	4.0 mm (copper coated)	
	Welding Method:	N.A	
6.2 Flux	Class:	F2 of IRS M.39	
	Type:	Agglomerated	
	Drying Method:	250° C to 300° C for two hour before use.	
6.3 Shielding gas	: N.A		
7.0 Base metal preparation	: Fusion faces and adjacent surfaces are cleaned and made free from cracks, notches, mill scale, grease, paint, rust etc., which might affect weld quality.		
7.1 Joint design details	: Sketch showing arrangements of parts, weld groove details, weld passes & their sequence etc.		

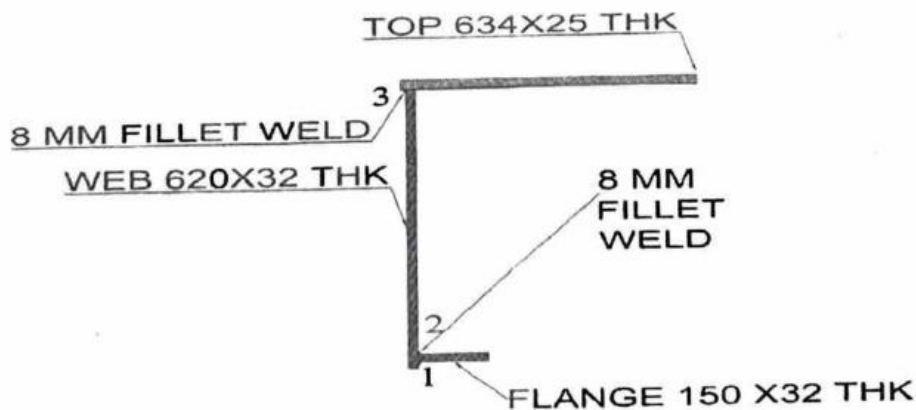

7.2 Joint preparation


As per IS 4353- 1995, Cl. 7, IRS B1 – 2001, Cl. 17.3, & WBC - 2001

91.4M OWG (25T LOADING)

8. Welding current : Type : DC
Polarity: Reverse
9. Welder qualification : First welder as per IS-7307 (part-I) First welder at all test then other welder As per IS 7310 (Part I) – 1974
10. Welding parameters and technique :
- 10.1 Welding parameter :

Weld Pass		Electrodes/ Wire dia. (mm)	Current Amp.	Arc Voltage (volt)	Wire feed Speed (m/min)	Travel Speed (m/min)	Electrode Stick out (mm)	Gas flow (l/min)
Front side single	Back Side single							
		4	450-550	28-30	controlled by current	0.45-0.50	15-20	N.A

- 10.2 Welding sequence :

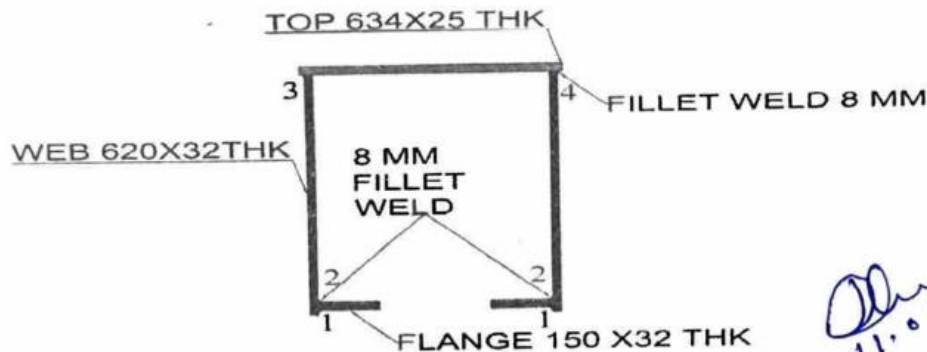

11. Provision of running & run off tabs : Yes
12. Cleaning of weld bead before laying next weld bead : N.A.
13. Root preparation before welding other side of groove weld : N.A.
14. Preheating & interpass temperature : Min-150°C , Interpass Max- 250°C
15. Peening : N.A
16. Post weld treatment : N.A.
17. Rectification of weld defects : By grinding of the defective weld & rectifying the weld as per CI 32.2 of IS 9595-96, using A3 class of electrodes of specn IRS M.28-12 after conducting D P test.
18. Inspection of weld : Visually, D.P.Test & Macro Etching

11.06.21
आसिस्टंट रिसर्च ऑफिसर (मेट)
असिस्टंट रिसर्च ऑफिसर (मेट)

7/55


91.4M OWG (25T LOADING)

Welding Procedure Specification Sheet (WPSS)

Name and Address of Fabricator : M/s M G Contractors Pvt. Ltd.,
Vill- Gola, Kalpi-Naraingarh Road,
Opposite E-max Education City,
Mullana, Ambala (HR) 133104
Welding procedure specification No. : MGCPL/20-21/DFCCIL/SSM-RFO/91.4M/GMAW/WPSS-11

1. Drawing No. : RDSO/B-17184 (U6-U7)
DETAILS OF TOP CHORD
2. Weld joint description : WEB(20 MM) WITH TOP PLATE(16MM) INNER SIDE (8MM)
3. Base metal : IS 2062 : 2011 E 350 Quality- B0
4. Welding process : GMAW
5. Welding position : horizontal
6. Welding consumables : Class: Class 1 of IRS M.46
- 6.1 Electrode/wire – Electrode : Type: Copper coated solid wire
Dia: 1.2 mm (copper coated)
Drying Method: N.A.
- 6.2 Flux : Class: N.A.
Type: N.A.
Drying Method: N.A.
- 6.3 Shielding gas : CO₂
- 7.0 Base metal preparation : Fusion faces and adjacent surfaces are cleaned and made free from cracks, notches, mill scale, grease, paint, rust etc., which might affect weld quality
- 7.1 Joint design details : Sketch showing arrangements of parts, weld details, weld passes & their sequence etc.

[Signature]
11-06-21
विकास अनुसंधान अधिकारी (मेटल)
Assistant Research Officer (Met)
भारतीय रेलवे संस्थान, दिल्ली

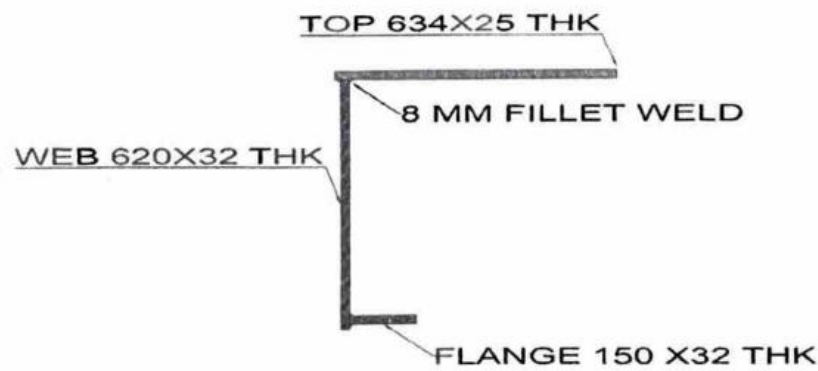

- 7.2 Joint preparation : As per IS 10178, Cl. 7, IRS B1 – 2001, Cl. 17.3, & WBC - 2001
8. Welding current : Type: DC
Polarity: Reverse
9. Welder qualification : First Welder as per IS-7307(part-I) First welder at all test then other welder As per IS 7310 (Part I) – 1974




91.4M OWG (25T LOADING)

10. Welding parameters and technique :

10.1 Welding parameter :

Weld Pass		Electrodes/ Wire dia. (mm)	Current Amp.	Arc Voltage (volt)	Wire feed Speed (m/min)	Travel Speed (m/min)	Electrode Stick out (mm)	Gas flow (l/min)
Front side	Back Side							
	single	1.2	180-220	22-26	Controlled by Current	N.A.	12-15	15-18

10.2 Welding sequence :

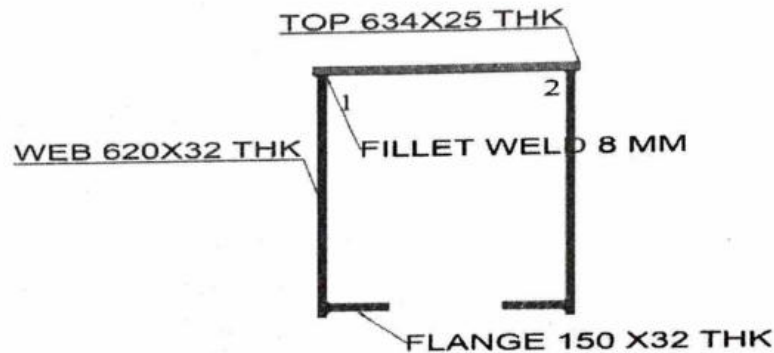

11. Provision of running & run off tabs : Yes

12. Cleaning of weld bead before laying next weld bead : N.A.

13. Root preparation before welding other side of groove weld : N.A.

14. Preheating & interpass temperature : Min-75°C , Interpass Max- 250°C

15. Peening : N.A.

16. Post weld treatment : N.A.

17. Rectification of weld defects : By grinding of the defective weld & rectifying the weld as per CI 32.2 of IS 9595-96, using A3 class of electrodes of specn IRS M.28-12 after conducting D P test.

18. Inspection of weld : Visually, D.P. Test & Macro Etching

21.06.21
 सहायक अनुसंधान अधिकारी (धातु)
 Assistant Research Officer (Met)
 क.प.प्रा.सं. रेल मंत्रालय बलनस-11

7/37

91.4M OWG (25T LOADING)

Welding Procedure Specification Sheet (WPSS)

Name and Address of Fabricator

M/s M.G. Contractors Pvt. Ltd.,
Vill- Gola, Kalpi-Naraingarh Road,
Opposite E-max Education City,
Mullana, Ambala (HR) 133104
MGCP/20-21/DFCCIL/SSM-RFO/91.4M/SAW/WPSS-012

Welding procedure specification No.

1. Drawing No.

RDSO/B-17184 (L0-M0 & M0-L0)
DETAILS OF END RAKER

2. Weld joint description

WEB (25 MM) WITH FLANGE (20MM) FILLET WELD (8MM)
WEB(25MM) WITH TOP PLATE(25MM) OUTER SIDE (8MM)
IS:2062 : 2011 E 350 Quality - B0

3. Base metal

Submerged Arc Welding (SAW)

4. Welding process

Flat

5. Welding position

6. Welding consumables

6.1 Electrode/wire - Electrode

Class: W2 of IRS M.39
Type: Copper coated solid wire
Dia: 4.0 mm (copper coated)

6.2 Flux

Drying Method: N.A
Class: F2 of IRS M.39
Type: Agglomerated
Drying Method: 250° C to 300° C for two hour before use.

6.3 Shielding gas


N.A

7.0 Base metal preparation

Fusion faces and adjacent surfaces are cleaned and made free from cracks, notches, mill scale, grease, paint, rust etc., which might affect weld quality.

7.1 Joint design details

Sketch showing arrangements of parts, weld groove details, weld passes & their sequence etc.

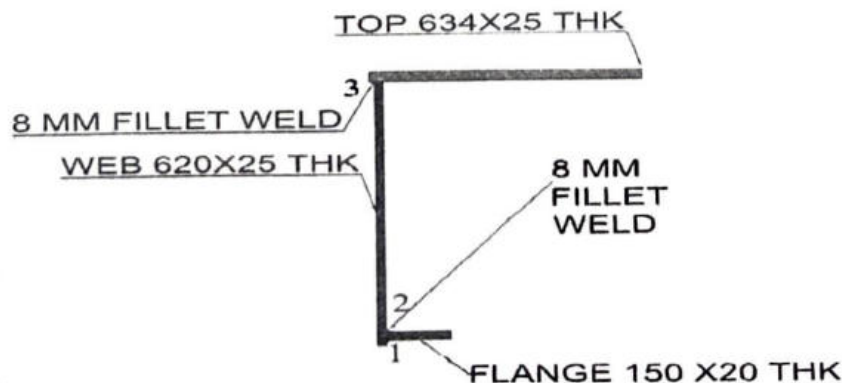

7.2 Joint preparation

As per IS 4353- 1995, Cl. 7, IRS B1 - 2001, Cl. 17.3, & WBC - 2001

8. Welding current

Type: DC
Polarity: Reverse




91.4M OWG (25T LOADING)

9. Welder qualification : First welder as per IS-7307(part-I) First welder at all test then other welder As per IS 7310 (Part I) – 1974
10. Welding parameters and technique :
- 10.1 Welding parameter :

Weld Pass		Electrodes/ Wire dia. (mm)	Current Amp.	Arc Voltage (volt)	Wire feed Speed (m/min)	Travel Speed (m/min)	Electrode Stick out (mm)	Gas flow (l/min)
Front side	Back Side							
single	single	4	450-550	28-30	controlled by current	0.45-0.50	15-20	N.A

- 10.2 Welding sequence :

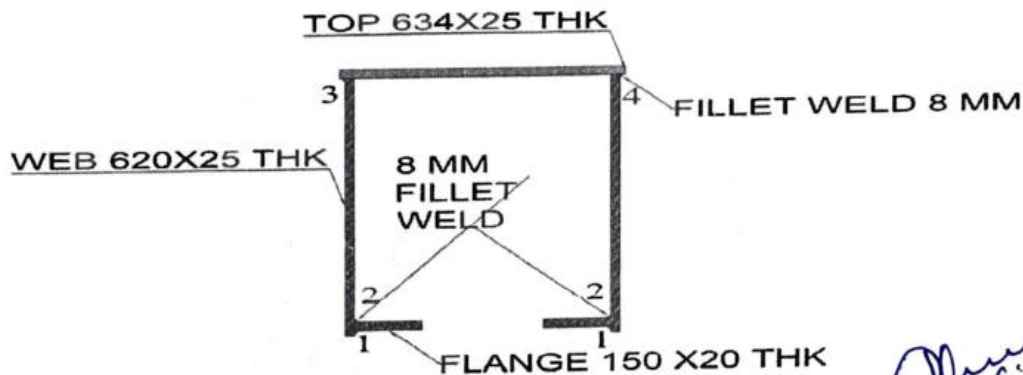

11. Provision of running & run off tabs : Yes
12. Cleaning of weld bead before laying next weld bead : N.A.
13. Root preparation before welding other side of groove weld : N.A.
14. Preheating & interpass temperature : Min-150°C , Interpass Max- 250°C
15. Peening : N.A.
16. Post weld treatment : N.A.
17. Rectification of weld defects : By grinding of the defective weld & rectifying the weld as per Cl 32.2 of IS 9595-96, using A3 class of electrodes of specn IRS M.28-12 after conducting D P test.
18. Inspection of weld : Visually, D.P.Test & Macro Etching

11.06.22 (शुक्र)
 सहायक अनुसंधान अधिकारी (मेट)
 Assistant Research Officer (Met)

7/59


91.4M OWG (25T LOADING)

Welding Procedure Specification Sheet (WPSS)

Name and Address of Fabricator : M/s M.G Contractors Pvt. Ltd.,
Vill- Gola, Kalpi-Naraingarh Road,
Opposite E-max Education City,
Mullana, Ambala (HR) 133104
Welding procedure specification No. MGCP/20-21/DFCCIL/SSM-RFO/91.4M/GMAW/WPSS-013

1. Drawing No. : RDSO/B-17184 (L0-M0 & M0-L0)
DETAILS OF END RAKER
2. Weld joint description : WEB(28 MM) WITH TOP PLATE(28MM) INNER SIDE (8MM)
3. Base metal : IS 2062 : 2011 E 350 Quality -B0
4. Welding process : GMAW
5. Welding position : horizontal
6. Welding consumables :
6.1 Electrode/wire – Electrode : Class: Class 1 of IRS M.46
Type: Copper coated solid wire
Dia: 1.2 mm (copper coated)
Drying Method: N.A
- 6.2 Flux : Class: N.A.
Type: N.A
Drying Method: N.A.
- 6.3 Shielding gas : CO₂
- 7.0 Base metal preparation : Fusion faces and adjacent surfaces are cleaned and made free from cracks, notches, mill scale, grease, paint, rust etc., which might affect weld quality.
- 7.1 Joint design details : Sketch showing arrangements of parts, weld details, weld passes & their sequence etc.

[Signature]
11-06-2020
श्रीमती (मातु)
असिस्टन्ट रिसर्च ऑफिसर (मेट)

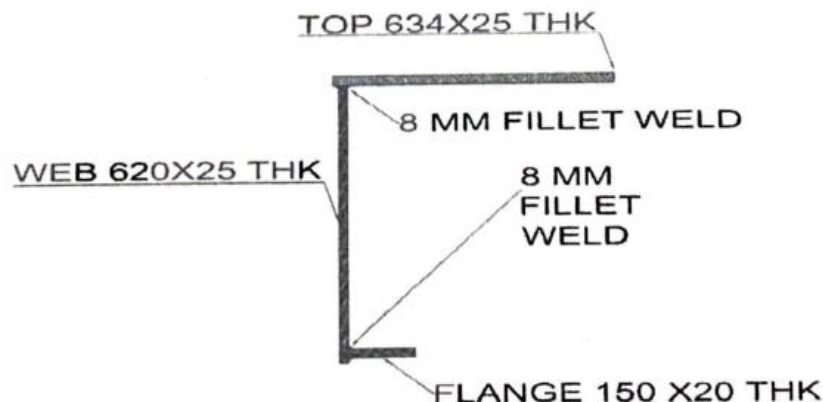

- 7.2 Joint preparation : As per IS 10178, Cl. 7, IRS B1 – 2001, Cl. 17.3, & WBC - 2001
8. Welding current : Type: DC
Polarity: Reverse
9. Welder qualification : First welder as per IS-7307(part-I) First welder at all test then other welder As per IS 7310 (Part I) – 1974



7/40


91.4M OWG (25T LOADING)

10. Welding parameters and technique :

10.1 Welding parameter :

Weld Pass		Electrodes/ Wire dia. (mm)	Current Amp.	Arc Voltage (volt)	Wire feed Speed (m/min)	Travel Speed (m/min)	Electrode Stick out (mm)	Gas flow (l/min)
Front side	Back Side							
	single	1.2	200-220	24-26	4-5	N.A.	12-15	15-18

10.2 Welding sequence :

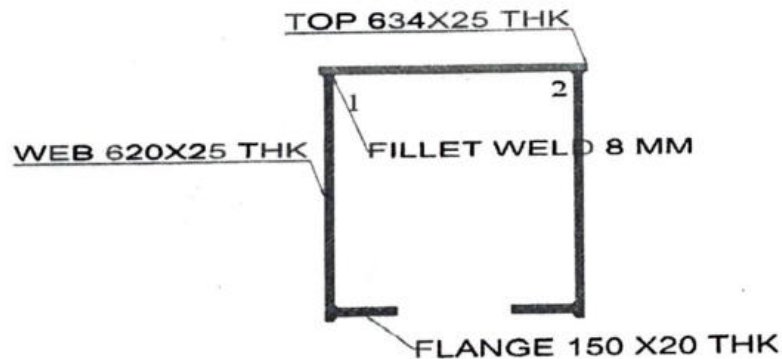

11. Provision of running & run off tabs : Yes

12. Cleaning of weld bead before laying next weld bead : N.A.

13. Root preparation before welding other side of groove weld : N.A.

14. Preheating & interpass temperature : Min-75°C , Interpass Max- 250°C

15. Peening : N.A.

16. Post weld treatment : N.A.

17. Rectification of weld defects : By grinding of the defective weld & rectifying the weld as per CI 32.2 of IS 9595-96, using A3 class of electrodes of specn IRS M.28-12 after conducting D P test.

18. Inspection of weld : Visually, D.P. Test & Macro Etching


(Signature)

91.4M OWG (25T LOADING)

Welding Procedure Specification Sheet (WPSS)

Name and Address of Fabricator : M/s M.G. Contractors Pvt. Ltd.,
Vill- Gola, Kalpi-Naraingarh Road,
Opposite E-max Education City,
Mullana, Ambala (HR) 133104
Welding procedure specification No. : MGCPL/20-21/DFCCIL/SSM-RFO/91.4M/SAW/WPSS-14

1. Drawing No. : RDSO/B-17184 (M0-U1, M0-L1)
DETAILS OF DIAGONALS
2. Weld joint description : WEB(20 MM) WITH FLANGE (16MM)FILLET WELD (8MM)
3. Base metal : IS:2062 : 2011 E 350 Quality -B0
4. Welding process : Submerged Arc Welding (SAW)
5. Welding position : Flat
6. Welding consumables :
6.1 Electrode/wire – Electrode : Class: W2 of IRS M.39
Type: Copper coated solid wire
Dia: 4.0 mm (copper coated)
Drying Method: N.A
- 6.2 Flux : Class: F2of IRS M.39
Type: : Agglomerated
Drying Method: 250° C to 300° C for two hour before use.
- 6.3 Shielding gas : N.A
- 7.0 Base metal preparation : Fusion faces and adjacent surfaces are cleaned and made free from cracks, notches, mill scale, grease, paint, rust etc., which might affect weld quality.
- 7.1 Joint design details : Sketch showing arrangements of parts, weld groove details, weld passes & their sequence etc.

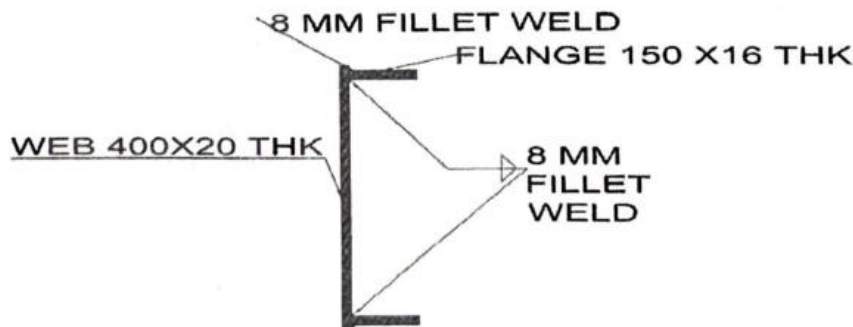

7.2 Joint preparation

: As per IS 4353- 1995, Cl. 7, IRS B1 – 2001, Cl. 17.3, & WBC - 2001



उप मुख्य परियोजना प्रबंधक


7/42

91.4M OWG (25T LOADING)

8. Welding current : Type: DC
Polarity: Reverse
9. Welder qualification : First welder as per IS-7307(part -I) First welder at all test then other welder As per IS 7310 (Part I) - 1974
10. Welding parameters and technique :
- 10.1 Welding parameter :

Weld Pass		Electrodes/ Wire dia. (mm)	Current Amp.	Arc Voltage (volt)	Wire feed Speed (m/min)	Travel Speed (m/min)	Electrode Stick out (mm)	Gas flow (l/min)
Front side	Back Side							
single	single	4	450-550	28-30	controlled by current	0.45-0.50	15-20	N.A

- 10.2 Welding sequence :

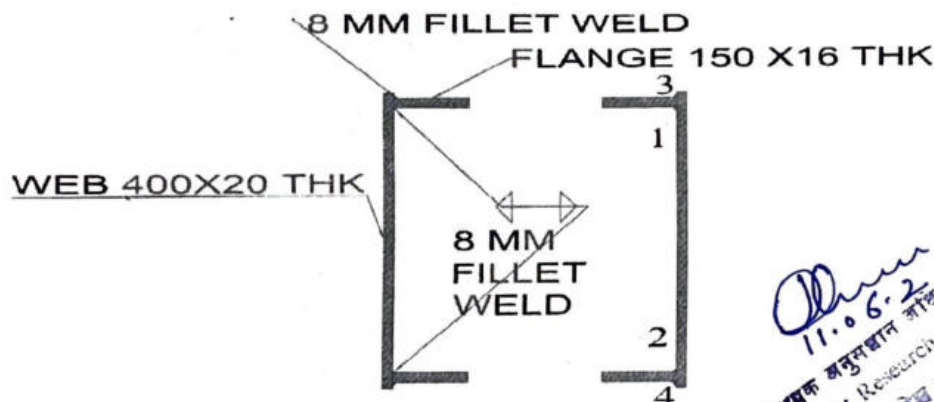

11. Provision of running & run off tabs : Yes
12. Cleaning of weld bead before laying next weld bead : N.A.
13. Root preparation before welding other side of groove weld : N.A.
14. Preheating & interpass temperature : Min-150°C , Interpass Max- 250°C
15. Peening : N.A
16. Post weld treatment : N.A.
17. Rectification of weld defects : By grinding of the defective weld & rectifying the weld as per Cl 32.2 of IS 9595-96, using A3 class of electrodes of specn IRS M.28-12 after conducting D P test.
18. Inspection of weld : Visually, D.P.Test & Macro Etching

11.06.2017

Asstnat Research Officer (Met)



91.4M OWG (25T LOADING)

Welding Procedure Specification Sheet (WPSS)

Name and Address of Fabricator	M/s M.G Contractors Pvt. Ltd., Vill- Gola, Kalpi-Naraingarh Road, Opposite E-max Education City, Mullana, Ambala (HR) 133104
Welding procedure specification No.	MGCP/20-21/DFCCIL/SSM-RFO/91.4M/SAW/WPSS-15
1. Drawing No.	RDSO/B-17184 (M1-U2) DETAILS OF DIAGONALS
2. Weld joint description	WEB(20 MM) WITH FLANGE (12MM)FILLET WELD (8MM)
3. Base metal	IS:2062 : 2011 E 350 Quality-B0
4. Welding process	Submerged Arc Welding (SAW)
5. Welding position	Flat
6. Welding consumables	
6.1 Electrode/wire – Electrode	Class: W2 of IRS M.39 Type: Copper coated solid wire Dia: 4.0 mm (copper coated) Drying Method: N.A
6.2 Flux	Class: F2of IRS M.39 Type: Agglomerated Drying Method: 250° C to 300° C for two hour before use.
6.3 Shielding gas	N.A
7.0 Base metal preparation	Fusion faces and adjacent surfaces are cleaned and made free from cracks, notches, mill scale, grease, paint, rust etc., which might affect weld quality.
7.1 Joint design details	Sketch showing arrangements of parts, weld groove details, weld passes & their sequence etc.

11.06.21
असिस्टन्ट रिसर्च ऑफिसर (मो.)

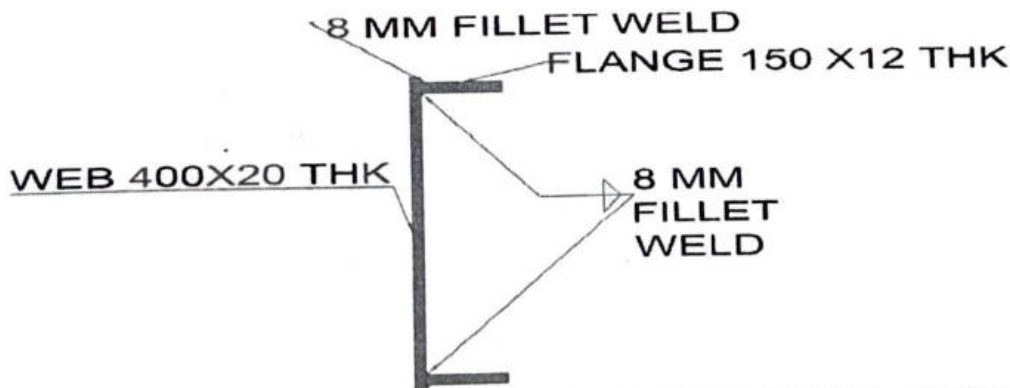

7.2 Joint preparation : As per IS 4353- 1995, Cl. 7, IRS B1 – 2001, Cl. 17.3, & WBC - 2001

8. Welding current



Type: Reverse
 Polarity: Reverse


7/44

91.4M OWG (25T LOADING)

9. Welder qualification : First welder as per IS-7307(part-I) first welder at all test then other welder As per IS 7310 (Part I) – 1974
10. Welding parameters and technique :
- 10.1 Welding parameter :

Weld Pass		Electrodes/ Wire dia. (mm)	Current Amp.	Arc Voltage (volt)	Wire feed Speed (m/min)	Travel Speed (m/min)	Electrode Stick out (mm)	Gas flow (l/min)
Front side	Back Side							
single	single	4	450-550	28-30	controlled by current	0.45-0.50	15-20	N.A

- 10.2 Welding sequence :

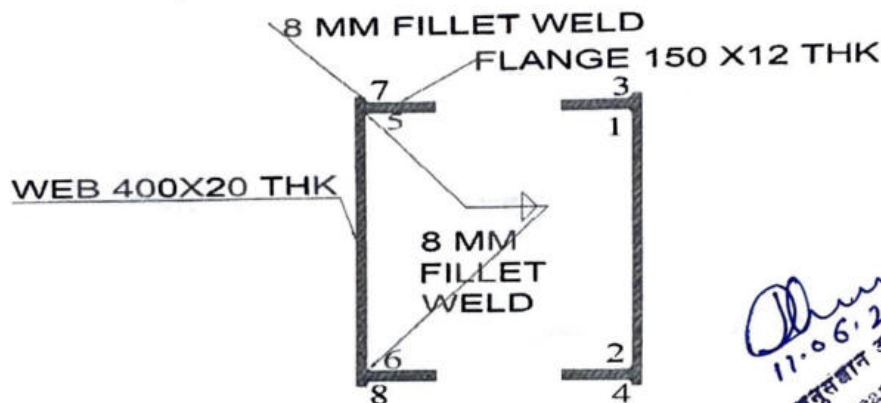

11. Provision of running & run off tabs : Yes
12. Cleaning of weld bead before laying next weld bead : N.A.
13. Root preparation before welding other side of groove weld : N.A.
14. Preheating & interpass temperature : Min-150°C , Interpass Max- 250°C
15. Peening : N.A.
16. Post weld treatment : N.A.
17. Rectification of weld defects : By grinding of the defective weld & rectifying the weld as per CI 32.2 of IS 9595-96, using A3 class of electrodes of specn IRS M.28-12 after conducting D P test.
18. Inspection of weld : Visually, D.P.Test & Macro Etching

(Signature)
 17.06.21
 Assistant Research Officer (Met)

7/45

91.4M OWG (25T LOADING)

Welding Procedure Specification Sheet (WPSS)


Name and Address of Fabricator

M/s M.G Contractors Pvt. Ltd.,
Vill- Gola, Kalpi-Naraingarh Road,
Opposite E-max Education City,
Mullana, Ambala (HR) 133104
MGCP/20-21/DFCCIL/SSM-RFO/91.4M/SAW/WPSS-16

Welding procedure specification No.

- | | | |
|-----|----------------------------|---|
| 1. | Drawing No. | : RDSO/B-17184 (M1-L2)
DETAILS OF DIAGONALS |
| 2. | Weld joint description | : WEB(16 MM) WITH FLANGE (12MM)FILLET WELD (8MM) |
| 3. | Base metal | : IS:2062 : 2011 E 350 Quality B0 |
| 4. | Welding process | : Submerged Arc Welding (SAW) |
| 5. | Welding position | : Flat |
| 6. | Welding consumables | : |
| 6.1 | Electrode/wire – Electrode | : Class: W2 of IRS M.39
Type: Copper coated solid wire
Dia: 4.0 mm (copper coated)
Drying Method: N.A |
| 6.2 | Flux | : Class: F2of IRS M.39
Type: Agglomerated
Drying Method: 250° C to 300° C for two hour before use. |
| 6.3 | Shielding gas | : N.A |
| 7.0 | Base metal preparation | : Fusion faces and adjacent surfaces are cleaned and made free from cracks, notches, mill scale, grease, paint, rust etc., which might affect weld quality. |
| 7.1 | Joint design details | : Sketch showing arrangements of parts, weld groove details, weld passes & their sequence etc. |

11.06.2017 (Mtg)
Assistant Research Officer (Met)

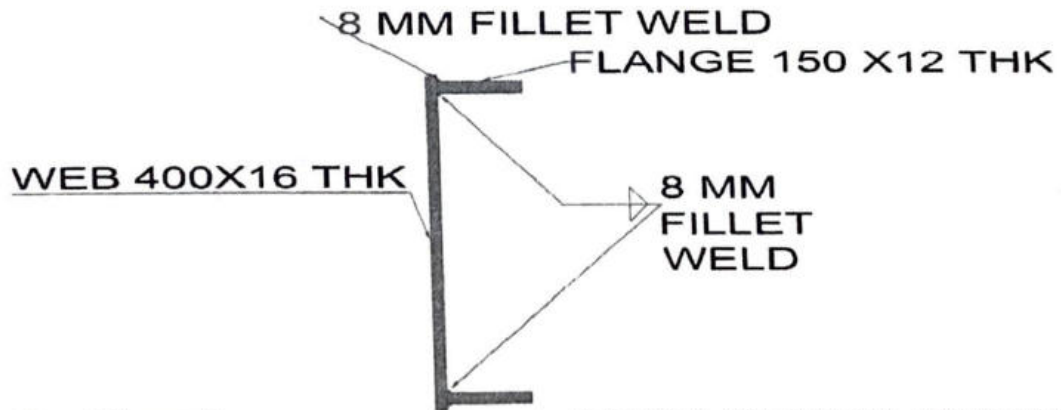

7.2 Joint preparation

: As per IS 4353- 1995, Cl. 7, IRS B1 – 2001, Cl. 17.3, & WBC - 2001

8. Welding current

Type: DC
Polarity: Reverse




7/46

91.4M OWG (25T LOADING)

9. Welder qualification : First welder as per IS-7307 (part-I) First welder at all test then other welder As per IS 7310 (Part I) – 1974
10. Welding parameters and technique :
- 10.1 Welding parameter :

Weld Pass		Electrodes/ Wire dia. (mm)	Current Amp.	Arc Voltage (volt)	Wire feed Speed (m/min)	Travel Speed (m/min)	Electrode Stick out (mm)	Gas flow (l/min)
Front side	Back Side							
single	single	4	450-550	28-30	controlled by current	0.45-0.50	15-20	N.A

- 10.2 Welding sequence :

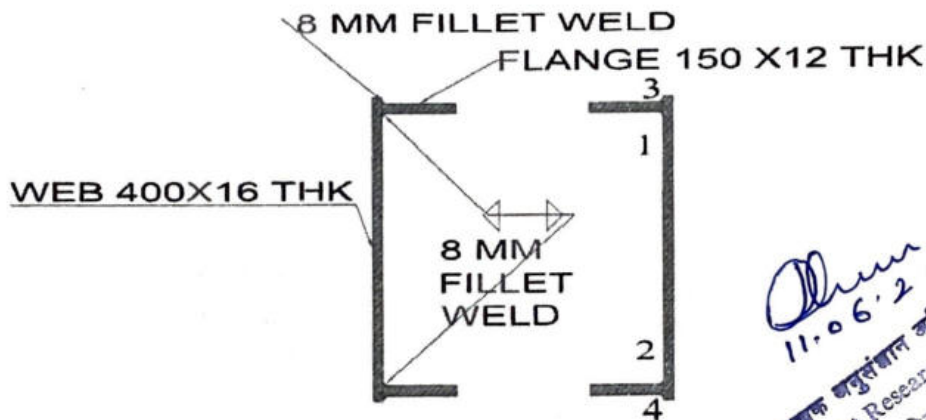

11. Provision of running & run off tabs : Yes
12. Cleaning of weld bead before laying next weld bead : N.A.
13. Root preparation before welding other side of groove weld : N.A.
14. Preheating & interpass temperature : Min-150°C , Interpass Max- 250°C
15. Peening : N.A
16. Post weld treatment : N.A.
17. Rectification of weld defects : By grinding of the defective weld & rectifying the weld as per Cl 32.2 of IS 9595-96, using A3 class of electrodes of specn IRS M.28-12 after conducting D P test.
18. Inspection of weld : Visually, D.P.Test & Macro Etching

11.06.21
 Assistant Research Officer (Met)

91.4M OWG (25T LOADING)

Welding Procedure Specification Sheet (WPSS)

Name and Address of Fabricator

M/s M.G. Contractors Pvt. Ltd.,
Vill- Gola, Kalpi-Naraingarh Road,
Opposite E-max Education City,
Mullana, Ambala (HR) 133104
MGCPL/20-21/DFCCIL/SSM-RFO/91.4M/SAW/WPSS-17

Welding procedure specification No.

1. Drawing No.
2. Weld joint description
3. Base metal
4. Welding process
5. Welding position
6. Welding consumables
- 6.1 Electrode/wire – Electrode

- : RDSO/B-17184 (M2-U3, M2-L3, M3-U4, M3-L4, M6-U7 & M6-L7)
DETAILS OF DIAGONALS
- : WEB(12 MM) WITH FLANGE (12MM)FILLET WELD (8MM)
- : IS:2062 : 2011 E 350 Quality B0
- : Submerged Arc Welding (SAW)
- : Flat

6.2 Flux

- : Class: W2 of IRS M.39
- : Type: Copper coated solid wire
- : Dia: 4.0 mm (copper coated)
- : Drying Method: N.A
- : Class: F2of IRS M.39
- : Type: : Agglomerated
- : Drying Method: 250° C to 300° C for two hour before use.

6.3 Shielding gas


: N.A

7.0 Base metal preparation

- : Fusion faces and adjacent surfaces are cleaned and made free from cracks, notches, mill scale, grease, paint, rust etc., which might affect weld quality.

7.1 Joint design details

- : Sketch showing arrangements of parts, weld groove details, weld passes & their sequence etc.

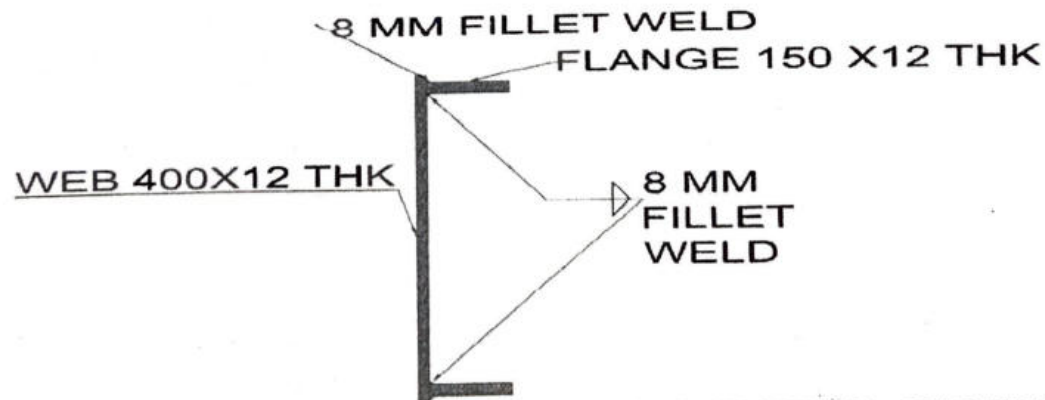

7.2 Joint preparation

- : As per IS 4353- 1995, Cl. 7, IRS B1 – 2001, Cl. 17.3, & WBC - 2001

8. Welding current

Type: DC
Polarity: Reverse




7/46

91.4M OWG (25T LOADING)

9. Welder qualification : First welder as per IS-7307 (part-I) First welder at all test then other welder As per IS 7310 (Part I) – 1974
10. Welding parameters and technique :
- 10.1 Welding parameter :

Weld Pass		Electrodes/ Wire dia. (mm)	Current Amp.	Arc Voltage (volt)	Wire feed Speed (m/min)	Travel Speed (m/min)	Electrode Stick out (mm)	Gas flow (l/min)
Front side	Back Side							
single	single	4	450-550	28-30	controlled by current	0.45-0.50	15-20	NA

- 10.2 Welding sequence :

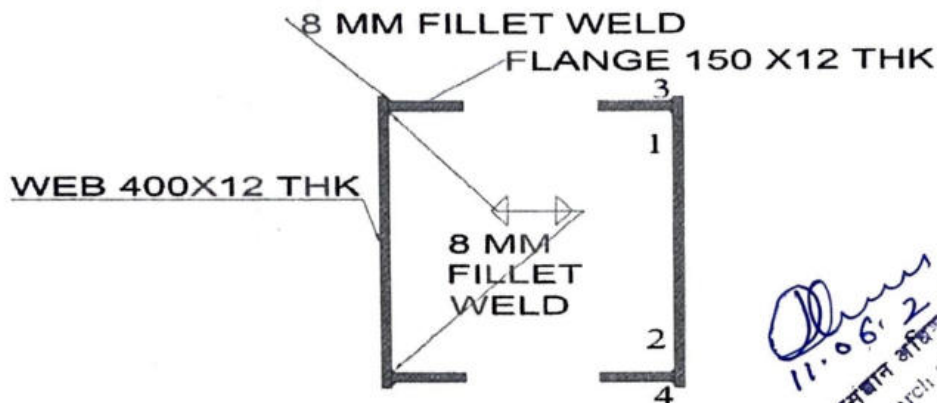

11. Provision of running & run off tabs : Yes
12. Cleaning of weld bead before laying next weld bead : N.A.
13. Root preparation before welding other side of groove weld : N.A.
14. Preheating & interpass temperature : Min-150°C , Interpass Max- 250°C
15. Peening : N.A.
16. Post weld treatment : N.A.
17. Rectification of weld defects : By grinding of the defective weld & rectifying the weld as per Cl 32.2 of IS 9595-96, using A3 class of electrodes of specn IRS M.28 after conducting D P test.
18. Inspection of weld : Visually, D.P.Test & Macro Etching

11.06.21 (Date)
 Assistant Research Officer (Weld)


7/49

91.4M OWG (25T LOADING)

Welding Procedure Specification Sheet (WPSS)

Name and Address of Fabricator	: M/s M.G Contractors Pvt. Ltd., Vill- Gola, Kalpi-Naraingarh Road, Opposite E-max Education City, Mullana, Ambala (HR) 133104
Welding procedure specification No.	MGCP/20-21/DFCCIL/SSM-RFO/91.4M/SAW/WPSS-18
1. Drawing No.	: RDSO/B-17184 (M4-U5, M4-L5, M5-U6 & M5-L6)
2. Weld joint description	: DETAILS OF DIAGONALS WEB(10 MM) WITH FLANGE (12MM)FILLET WELD (8MM)
3. Base metal	: IS:2062 : 2011 E 350 Quality B0
4. Welding process	: Submerged Arc Welding (SAW)
5. Welding position	: Flat
6. Welding consumables	
6.1 Electrode/wire – Electrode	: Class: W2 of IRS M.39 Type: Copper coated solid wire Dia. 4.0 mm (copper coated) Drying Method: N.A
6.2 Flux	: Class: F2of IRS M.39 Type : Agglomerated Drying Method: 250° C to 300° C for two hour before use.
6.3 Shielding gas	: N.A
7.0 Base metal preparation	: Fusion faces and adjacent surfaces are cleaned and made free from cracks, notches, mill scale, grease, paint, rust etc., which might affect weld quality.
7.1 Joint design details	: Sketch showing arrangements of parts, weld groove details, weld passes & their sequence etc.

11.06.21
 Assistant Research Officer (Met)
 DFCCIL

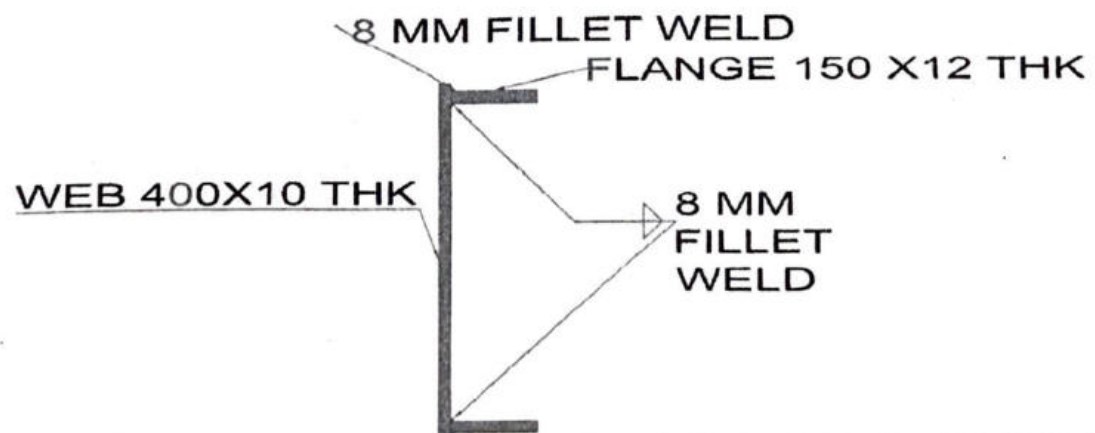

7.2 Joint preparation : As per IS 4353- 1995, Cl. 7, IRS B1 – 2001, Cl. 17.3, & WBC - 2001

8. Welding current : Type DC, Polarity Reverse




7/50

91.4M OWG (25T LOADING)

9. Welder qualification : First welder as per IS-7307 (part-I) First welder at all test then other welder As per IS 7310 (Part I) – 1974
10. Welding parameters and technique :
- 10.1 Welding parameter :

Weld Pass		Electrodes/ Wire dia. (mm)	Current Amp.	Arc Voltage (volt)	Wire feed Speed (m/min)	Travel Speed (m/min)	Electrode Stick out (mm)	Gas flow (l/min)
Front side	Back Side							
single	single	4	450-550	28-30	controlled by current	0.45-0.50	16-20	N.A

- 10.2 Welding sequence :

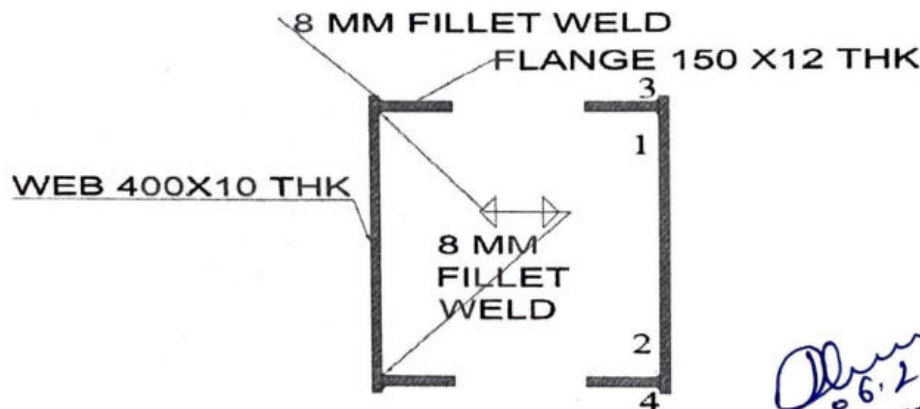

11. Provision of running & run off tabs : Yes
12. Cleaning of weld bead before laying next weld bead : N.A.
13. Root preparation before welding other side of groove weld : N.A.
14. Preheating & interpass temperature : Min-150°C , Interpass Max- 250°C
15. Peening : N.A.
16. Post weld treatment : N.A.
17. Rectification of weld defects : By grinding of the defective weld & rectifying the weld as per CI 32.2 of IS 9595-96, using A3 class of electrodes of specn IRS M.28-12 after conducting D P test.
18. Inspection of weld : Visually, D.P.Test & Macro Etching

11-06-21
 Assistant Research Officer (Met.)
 Research Station (Met.)

91.4M OWG (25T LOADING)

Welding Procedure Specification Sheet (WPSS)

Name and Address of Fabricator

: M/s M.G. Contractors Pvt. Ltd.,
Vill- Gola, Kalpi-Naraingarh Road,
Opposite E-max Education City,
Mullana, Ambala (HR) 133104
MGCPL/20-21/DFCCIL/SSM-RFO/91.4M/SAW/WPSS-19

Welding procedure specification No.

1. Drawing No.

: RDSO/B-17184 (M1-U1 & M1-L1)
DETAILS OF VERTICALS

2. Weld joint description

: WEB(16 MM) WITH FLANGE (25MM) FILLET WELD (6MM)

3. Base metal

: IS:2062 : 2011 E 350 Quality -B0

4. Welding process

: Submerged Arc Welding (SAW)

5. Welding position

: Flat

6. Welding consumables

6.1 Electrode/wire – Electrode

: Class: W2 of IRS M.39
Type: Copper coated solid wire
4.0 mm (copper coated)

: Drying Method: N.A

6.2 Flux

: Class: F2of IRS M.39

Type: Agglomerated

Drying Method: 250° C to 300° C for two hour before use.

6.3 Shielding gas


: N.A

7.0 Base metal preparation

: Fusion faces and adjacent surfaces are cleaned and made free from cracks, notches, mill scale, grease, paint, rust etc., which might affect weld quality.

7.1 Joint design details

: Sketch showing arrangements of parts, weld groove details, weld passes & their sequence etc.

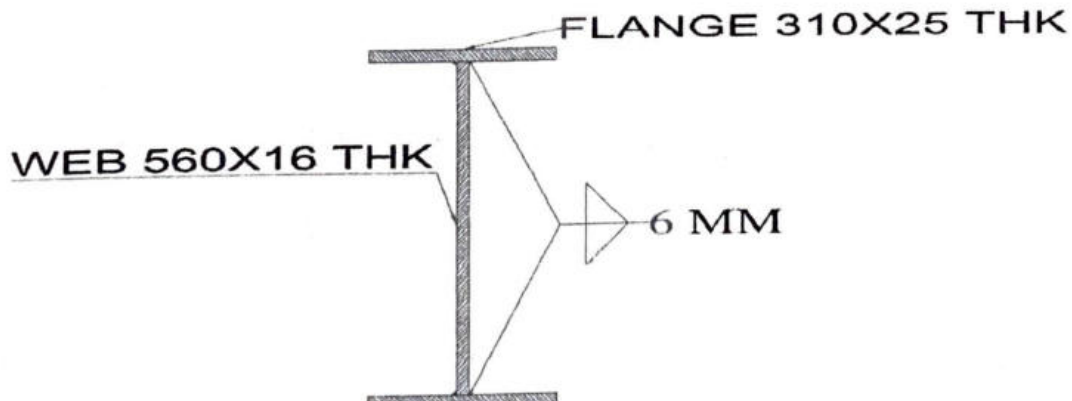

7.2 Joint preparation

: As per IS 4353- 1995, Cl. 7, IRS B1 – 2001, Cl. 17.3, & WBC - 2001

8. Welding current

: Type: DC
Polarity: Reverse




7/52

91.4M OWG (25T LOADING)

9. Welder qualification : First welder as per IS-7307(part-I) First welder at all test then other welder As per IS 7310 (Part I) – 1974
10. Welding parameters and technique :
- 10.1 Welding parameter :

Weld Pass		Electrodes/ Wire dia. (mm)	Current Amp.	Arc Voltage (volt)	Wire feed Speed (m/min)	Travel Speed (m/min)	Electrode Stick out (mm)	Gas flow (l/min)
Front side	Back Side							
single	single	4	450-500	28-30	controlled by current	0.50-0.55	15-20	N.A

- 10.2 Welding sequence :

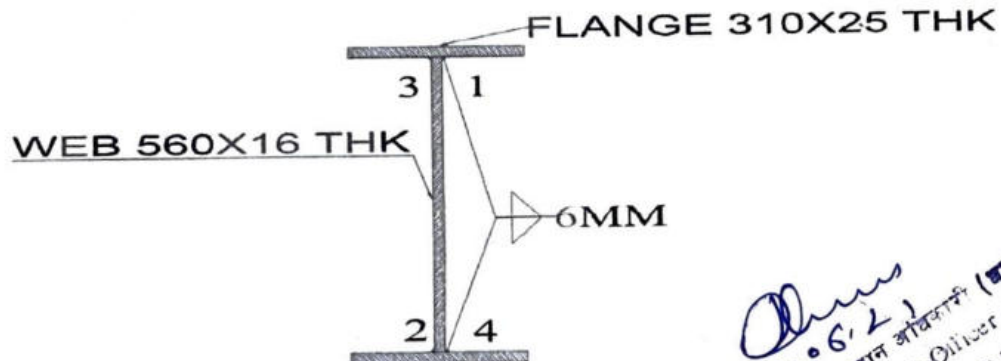

11. Provision of running & run off tabs : Yes
12. Cleaning of weld bead before laying next weld bead : N.A.
13. Root preparation before welding other side of groove weld : N.A.
14. Preheating & interpass temperature : Min-150°C , Interpass Max- 250°C
15. Peening : N.A.
16. Post weld treatment : N.A.
17. Rectification of weld defects : By grinding of the defective weld & rectifying the weld as per Cl 32.2 of IS 9595-96, using A3 class of electrodes of specn IRS M.28-12 after conducting D P test
18. Inspection of weld : Visually, D.P. Test & Macro Etching

11.06.21
 अनुसंधान अधिकारी (जाग)
 Assistant Research Officer (Met)

7/53

91.4M OWG (25T LOADING)

Welding Procedure Specification Sheet (WPSS)

Name and Address of Fabricator

M/s M.G Contractors Pvt. Ltd.,
Vill- Gola, Kalpi-Naraingarh Road,
Opposite E-max Education City,
Mullana, Ambala (HR) 133104
MGCPL/20-21/DFCCIL/SSM-RFO/91.4M/SAW/WPSS-20

Welding procedure specification No.

1. Drawing No.

RDSO/B-17184 (M2-U2 & M2-L2)
DETAILS OF VERTICALS

2. Weld joint description

WEB(16 MM) WITH FLANGE (16MM)FILLET WELD (6MM)

3. Base metal

IS:2062 : 2011 E 350 Quality -B0

4. Welding process

Submerged Arc Welding (SAW)

5. Welding position

Flat

6. Welding consumables

Class: W2 of IRS M.39

6.1 Electrode/wire – Electrode

Type: Copper coated solid wire

Dia: 4.0 mm (copper coated)

6.2 Flux

Drying Method: N.A

Class: F2of IRS M.39

Type: Agglomerated

Drying Method: 250° C to 300° C for two hour before use.

6.3 Shielding gas


N.A

7.0 Base metal preparation

Fusion faces and adjacent surfaces are cleaned and made free from cracks, notches, mill scale, grease, paint, rust etc., which might affect weld quality.

7.1 Joint design details

Sketch showing arrangements of parts, weld groove details, weld passes & their sequence etc.

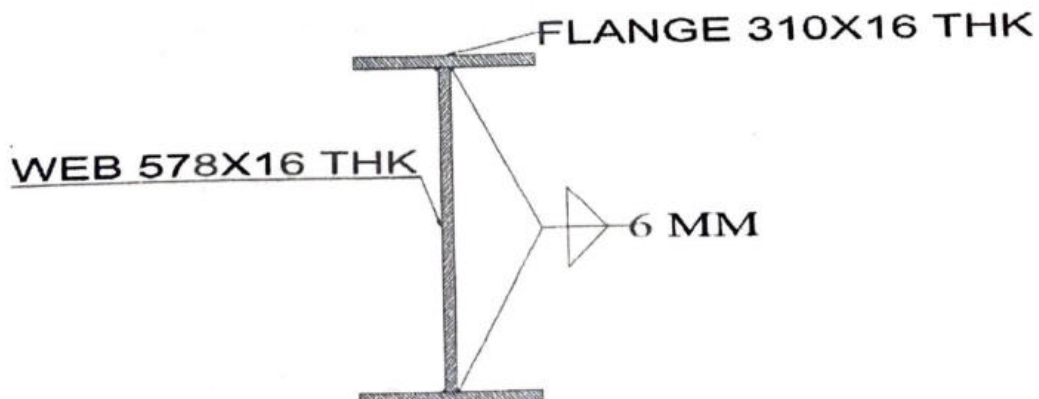

7.2 Joint preparation

As per IS 4353- 1995, Cl. 7, IRS B1 – 2001, Cl. 17.3, & WBC - 2001




संयोजक अभियंता प्रबंधक

91.4M OWG (25T LOADING)

8. Welding current : Type : DC
Polarity: Reverse
9. Welder qualification : First welder as per IS-7307(part-I) First welder at all test then other welder As per IS 7310 (Part I) – 1974
10. Welding parameters and technique :
- 10.1 Welding parameter :

Weld Pass		Electrodes/ Wire dia. (mm)	Current Amp.	Arc Voltage (volt)	Wire feed Speed (m/min)	Travel Speed (m/min)	Electrode Stick out (mm)	Gas flow (l/min)
Front side	Back Side							
single	single	4	450-500	28-30	controlled by current	0.50-0.55	15-20	N A

- 10.2 Welding sequence

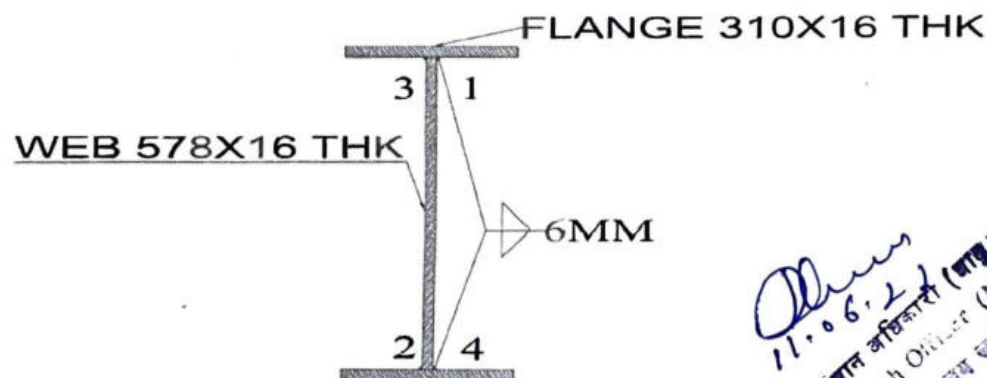

11.06.22 (Date)
Assistant Research Officer (Met)
Research Officer (Met)

11. Provision of running & run off tabs : Yes
12. Cleaning of weld bead before laying next weld bead : N.A.
13. Root preparation before welding other side of groove weld : N.A.
14. Preheating & interpass temperature : Min-150°C , Interpass Max- 250°C
15. Peening : N.A.
16. Post weld treatment : N.A.
17. Rectification of weld defects : By grinding of the defective weld & rectifying the weld as per Cl 32.2 of IS 9595-96, using A3 class of electrodes of specn IRS M.28-12 after conducting D P test.
18. Inspection of weld : Visually, D.P. Test & Macro Etching

7/55

: M/s M.G.Contractors Pvt. Ltd.,
Vill- Gola, Kalpi-Naraingarh Road,
Opposite E-max Education City,
Mullana, Ambala (HR) 133104
MGCPL/20-21/DFCCIL/SSM-RFO/91.4M/SAW/WPSS-21

RDSO/B-17184 (M3-U3, M3-L3, M4-U4, M4-L4, M5-U5, M5-L5,
M6-U6, M6-L6 & U7-L7)
DETAILS OF VERTICALS

: WEB(10 MM) WITH FLANGE (12MM)FILLET WELD (6MM)

: IS:2062 : 2011 E 350 Quality -B0

: Submerged Arc Welding (SAW)

Flat

Class: W2 of IRS M.39

Type: Copper coated solid wire

Dia: 4.0 mm (copper coated)

Drying Method: N.A

: Class: F2of IRS M.39


Type: : Agglomerated

Drying Method: 250^o C to 300^o C for two hour before use.

: N.A

Fusion faces and adjacent surfaces are cleaned and made free from cracks, notches, mill scale, grease, paint, rust etc., which might affect weld quality.

: Sketch showing arrangements of parts, weld groove details, weld passes & their sequence etc.

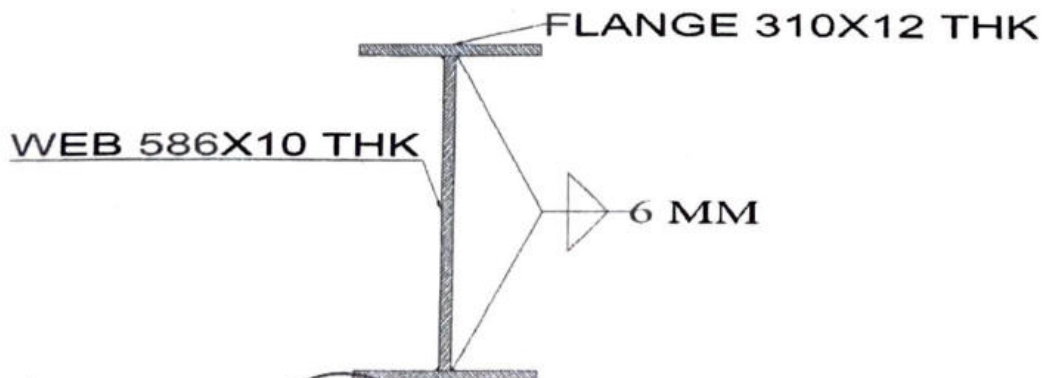


As per IS 4353- 1995, Cl. 7, IRS B1 – 2001, Cl. 17.3, & WBC - 2001

91.4M OWG (25T LOADING)

8. Welding current : Type : DC
Polarity: Reverse
9. Welder qualification : First welder as per IS-7307(part-I) First welder at all test then other welder As per IS 7310 (Part I) – 1974
10. Welding parameters and technique :
- 10.1 Welding parameter :

Weld Pass		Electrodes/ Wire dia. (mm)	Current Amp.	Arc Voltage (volt)	Wire feed Speed (m/min)	Travel Speed (m/min)	Electrode Stick out (mm)	Gas flow (l/min)
Front side	Back Side							
single	single	4	450-500	28-30	controlled by current	0.45-0.50	15-20	N.A

- 10.2 Welding sequence :

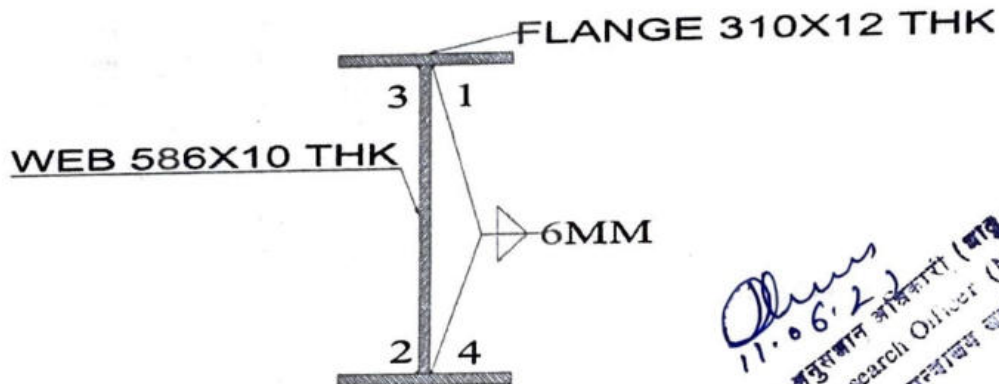

11.06.21
 Assistant Research Officer (Met)
 Research Officer (Met)


11. Provision of running & run off tabs : Yes
12. Cleaning of weld bead before laying next weld bead : N.A.
13. Root preparation before welding other side of groove weld : N.A.
14. Preheating & interpass temperature : Min-150°C , Interpass Max- 250°C
15. Peening : N.A
16. Post weld treatment : N.A.
17. Rectification of weld defects : By grinding of the defective weld & rectifying the weld as per Cl 32.2 of IS 9595-96, using A3 class of electrodes of specn IRS M.28-12 after conducting D P test.
18. Inspection of weld : Visually, D.P.Test & Macro Etching

91.4M OWG (25T LOADING)

Welding Procedure Specification Sheet (WPSS)

Name and Address of Fabricator : M/s M.G. Contractors Pvt. Ltd.,
Vill- Gola, Kalpi-Naraingarh Road,
Opposite E-max Education City,
Mullana, Ambala (HR) 133104
Welding procedure specification No. : MGCP/L/20-21/DFCCIL/SSM-RFO/91 4M/SAW/WPSS-22

1. Drawing No. : RDSO/B-17184
DETAILS OF CROSS GIRDERS
2. Weld joint description : WEB(16 MM) WITH FLANGE (40 MM) FILLET WELD (12 MM)
3. Base metal : IS:2062 : 2011 E 350 Quality- B0
4. Welding process : Submerged Arc Welding (SAW)
5. Welding position : Flat
6. Welding consumables :
6.1 Electrode/wire – Electrode : Class: W2 of IRS M.39
Type: Copper coated solid wire
Dia: 4.0 mm (copper coated)
- 6.2 Flux : Drying Method: N.A
Class: F2 of IRS M.39
Type: Agglomerated
Drying Method: 250° C to 300° C for two hour before use.
- 6.3 Shielding gas : N.A
- 7.0 Base metal preparation : Fusion faces and adjacent surfaces are cleaned and made free from cracks, notches, mill scale, grease, paint, rust etc., which might affect weld quality.
- 7.1 Joint design details : Sketch showing arrangements of parts, weld groove details, weld passes & their sequence etc.

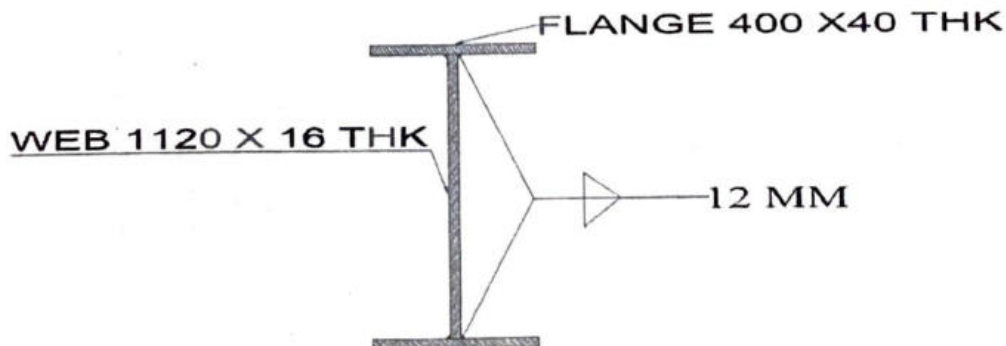

7.2 Joint preparation : As per IS 4353- 1995, Cl. 7, IRS B1 – 2001, Cl. 17.3, & WBC - 2001

8. Welding current

Type: DC
Polarity: Reverse




91.4M OWG (25T LOADING)

9. Welder qualification : First welder as per IS-7307(part-I) First welder at all test then other welder As per IS 7310 (Part I) – 1974
10. Welding parameters and technique :
- 10.1 Welding parameter :

Weld Pass		Electrodes/ Wire dia. (mm)	Current Amp.	Arc Voltage (volt)	Wire feed Speed (m/min)	Travel Speed (m/min)	Electrode Stick out (mm)	Gas flow (l/min)
Front side single	Back Side single							
		4	450-500	28-30	controlled by current	0.35-0.40	15-20	N.A

- 10.2 Welding sequence :

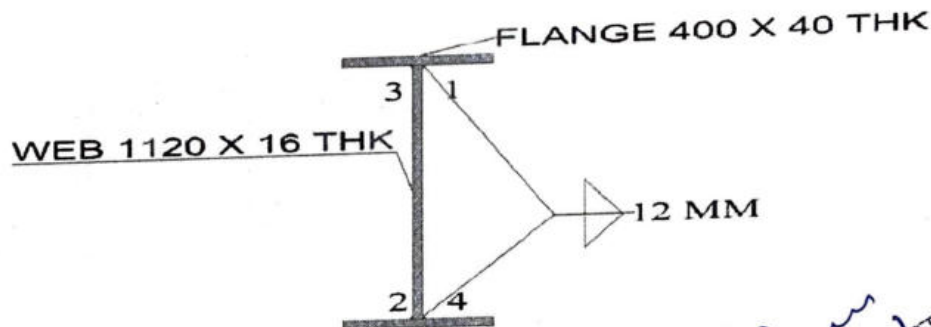

11. Provision of running & run off tabs : Yes
12. Cleaning of weld bead before laying next weld bead : N.A.
13. Root preparation before welding other side of groove weld : N.A.
14. Preheating & interpass temperature : Min-150°C , Interpass Max- 250°C
15. Peening : N.A.
16. Post weld treatment : N.A.
17. Rectification of weld defects : By grinding of the defective weld & rectifying the weld as per CI 32.2 of IS 9595-96, using A3 class of electrodes of specn IRS M.28 after conducting D P test.
18. Inspection of weld : Visually, D.P. Test & Macro Etching


11.06.21
Assistant Research Officer (Met)
कक्षा-१००० देव बनारस संयोजक-11

7/54

91.4M OWG (25T LOADING)

Welding Procedure Specification Sheet (WPSS)

Name and Address of Fabricator	: M/s M G Contractors Pvt. Ltd., Vill- Gola, Kalpi-Naraingarh Road, Opposite E-max Education City, Mullana, Ambala (HR) 133104 MGCP/20-21/DFCCIL/SSM-RFO/91.4M/SAW/WPSS-23
Welding procedure specification No.	: RDSO/B-17184 DETAILS OF STRINGERS
1. Drawing No.	: WEB(12 MM) WITH FLANGE (20 MM) FILLET WELD (12 MM)
2. Weld joint description	: IS.2062 : 2011 E 350 Quality -B0
3. Base metal	: Submerged Arc Welding (SAW)
4. Welding process	: Flat
5. Welding position	: Class: W2 of IRS M.39
6. Welding consumables	Type: Copper coated solid wire
6.1 Electrode/wire – Electrode	Dia: 4.0 mm (copper coated)
	Drying Method: N.A
6.2 Flux	: Class: F2 of IRS M.39
	Type: Agglomerated
	Drying Method: 250° C to 300° C for two hour before use.
6.3 Shielding gas	: N.A
7.0 Base metal preparation	: Fusion faces and adjacent surfaces are cleaned and made free from cracks, notches, mill scale, grease, paint, rust etc., which might affect weld quality.
7.1 Joint design details	: Sketch showing arrangements of parts, weld groove details, weld passes & their sequence etc.

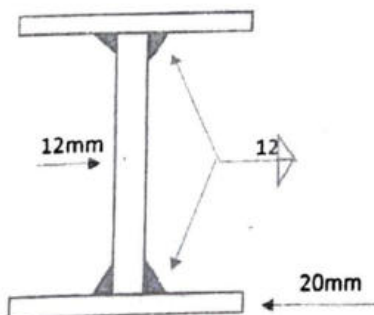

7.2 Joint preparation

8. Welding current



: As per IS 4353- 1995, Cl. 7, IRS B1 – 2001, Cl. 17.3, & WBC - 2001

उप मुख्य परियोजना प्रबंधक

Dr. C Type: DC

Polarity: Reverse

11.06.21
असुपक अनुसंधान अधिकारी (प्रा.)
Assistant Research Officer (Mech)
डॉ. ए. ए. ए. रेल. अकादमी, दिल्ली-11


7/60

91.4M OWG (25T LOADING)

9. Welder qualification : First welder As per IS-7307(part-I) first welder at all test then other welder As per IS 7310 (Part I) – 1974
10. Welding parameters and technique :
- 10.1 Welding parameter :

Weld Pass		Electrodes/ Wire dia. (mm)	Current Amp.	Arc Voltage (volt)	Wire feed Speed (m/min)	Travel Speed (m/min)	Electrode Stick out (mm)	Gas flow (l/min)
Front side	Back Side							
single	single	4	450-500	28-30	controlled by current	0.35-0.40	15-20	N.A

- 10.2 Welding sequence :

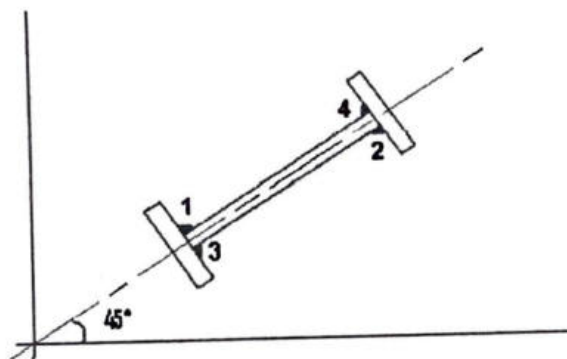

11-06-27
 आभुषण अनुसन्धान अधिकारी (मृग,
 Ambiant Research Officer (Mrg,
 आभुषण अनुसन्धान विभाग, दिल्ली-110002)

11. Provision of running & run off tabs : Yes
12. Cleaning of weld bead before laying next weld bead : N.A.
13. Root preparation before welding other side of groove weld : N.A.
14. Preheating & interpass temperature : Min-150°C , Interpass Max- 250°C
15. Peening : N.A.
16. Post weld treatment : N.A.
17. Rectification of weld defects : By grinding of the defective weld & rectifying the weld as per CI 32.2 of IS 9595-96, using A3 class of electrodes of specn IRS M.28-12 after conducting D P test.
18. Inspection of weld : Visually, D.P.Test & Macro Etching

9/61

91.4M OWG (25T LOADING)

Welding Procedure Specification Sheet (WPSS)

Name and Address of Fabricator

M/s M.G. Contractors Pvt. Ltd.,
Vill- Gola, Kalpi-Naraingarh Road,
Opposite E-max Education City,
Mullana, Ambala (HR) 133104
MGCP/20-21/DFCCIL/SSM-RFO/91.4M/SAW/WPSS-24

Welding procedure specification No.

1. Drawing No.

RDSO/B-17184
DETAILS OF PORTAL GIRDER

2. Weld joint description

WEB(15 MM) WITH FLANGE (15 MM) FILLET WELD (6 MM)

3. Base metal

IS:2062 : 2011 E 350 Quality -B0

4. Welding process

Submerged Arc Welding (SAW)

5. Welding position

Flat

6. Welding consumables

6.1 Electrode/wire - Electrode

Class: W2 of IRS M.39
Type: Copper coated solid wire
Dia: 4.0 mm (copper coated)

Drying Method: N.A

6.2 Flux

Class: F2 of IRS M.39

Type: Agglomerated

Drying Method: 250° C to 300° C for two hour before use.

6.3 Shielding gas

N.A


7.0 Base metal preparation

Fusion faces and adjacent surfaces are cleaned and made free from cracks, notches, mill scale, grease, paint, rust etc., which might affect weld quality.

7.1 Joint design details

Sketch showing arrangements of parts, weld groove details, weld passes & their sequence etc.

11.06.21
Assistant Research Officer (Met)
DRDO

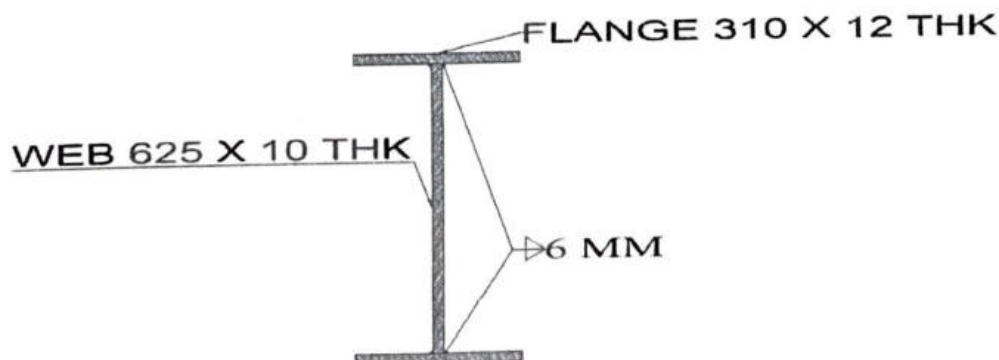

7.2 Joint preparation

As per IS 4353- 1995, Cl. 7, IRS B1 - 2001, Cl. 17.3, & WBC - 2001

8. Welding current

Type: DC
Polarity: Reverse




7/6/2

91.4M OWG (25T LOADING)

9. Welder qualification : First welder As per IS-7307(part-I) first welder at all test then other welder As per IS 7310 (Part I) – 1974
10. Welding parameters and technique :
- 10.1 Welding parameter :

Weld Pass		Electrodes/ Wire dia. (mm)	Current Amp.	Arc Voltage (volt)	Wire feed Speed (m/min)	Travel Speed (m/min)	Electrode Stick out (mm)	Gas flow (l/min)
Front side single	Back Side single	4	450-500	28-30	controlled by current	0.50-0.55	15-20	N A

- 10.2 Welding sequence :

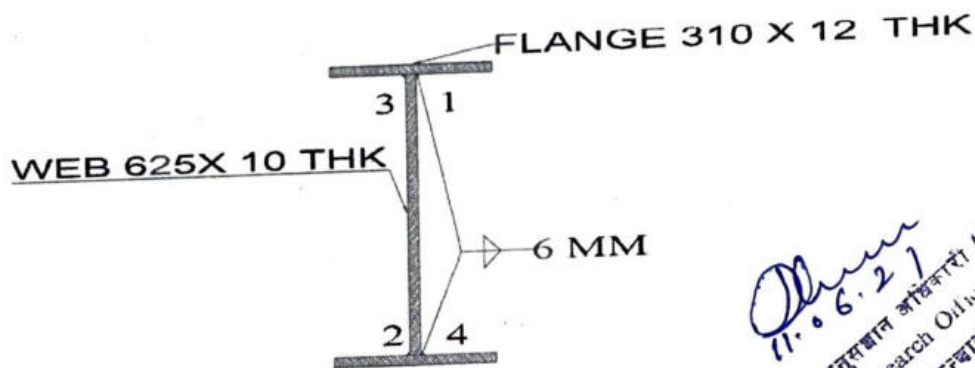

11.6.27
 Assistant Research Officer (Met)
 Research Officer (Met)
 Research Officer (Met)

11. Provision of running & run off tabs : Yes
12. Cleaning of weld bead before laying next weld bead : N.A.
13. Root preparation before welding other side of groove weld : N.A.
14. Preheating & interpass temperature : Min-150°C , Interpass Max- 250°C
15. Peening : N.A.
16. Post weld treatment : N.A.
17. Rectification of weld defects : By grinding of the defective weld & rectifying the weld as per CI 32.2 of IS 9595-96, using A3 class of electrodes of specn IRS M.28-12 after conducting D P test
18. Inspection of weld : Visually, D.P.Test & Macro Etching

7/63

91.4M OWG (25T LOADING)

Welding Procedure Specification Sheet (WPSS)


Name and Address of Fabricator : M/s M.G. Contractors Pvt. Ltd.,
Vill- Gola, Kalpi-Naraingarh Road,
Opposite E-max Education City,
Mullana, Ambala (HR) 133104
Welding procedure specification No. : MGCP/20-21/DFCCIL/SSM-RFO/91.4M/SAW/WPSS-25

1. Drawing No. : RDSO/B-17184
DETAILS OF SWAY GIRDER
2. Weld joint description : WEB(10 MM) WITH FLANGE (10 MM)FILLET WELD (6 MM)
3. Base metal : IS:2062 : 2011 E 350 Quality -B0
4. Welding process : Submerged Arc Welding (SAW)
5. Welding position : Flat
6. Welding consumables : Class: W2 of IRS M.39
- 6.1 Electrode/wire – Electrode : Type: Copper coated solid wire
Dia: 4.0 mm (copper coated)

Handwritten signature and stamp:
11.06.21
अनुमान अधिकारी (मत्)
Assistant Research Officer (Met)
डिप्टी प्रमुख, रेल मंत्रालय, नई दिल्ली

- 6.2 Flux : Drying Method: N.A
Class: F2 of IRS M.39
Type: Agglomerated
Drying Method: 250° C to 300° C for two hour before use.

- 6.3 Shielding gas : N.A
- 7.0 Base metal preparation : Fusion faces and adjacent surfaces are cleaned and made free from cracks, notches, mill scale, grease, paint, rust etc., which might affect weld quality.
- 7.1 Joint design details : Sketch showing arrangements of parts, weld groove details, weld passes & their sequence etc.

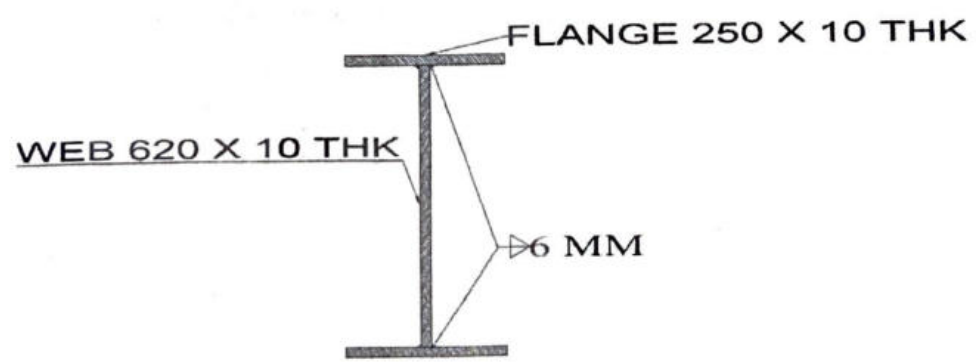

- 7.2 Joint preparation : As per IS 4353- 1995, Cl. 7, IRS B1 – 2001, Cl. 17.3, & WBC - 2001



Handwritten text:
प्रमुख परियोजना प्रबंधक
Chief Project Manager


7/64

91.4M OWG (25T LOADING)

8. Welding current : Type : DC
Polarity: Reverse
9. Welder qualification : First welder As per IS-7307(part-I) first welder at all test
then other welder As per IS 7310 (Part I) - 1974
10. Welding parameters and technique :
- 10.1 Welding parameter :

Weld Pass		Electrodes/ Wire dia. (mm)	Current Amp.	Arc Voltage (volt)	Wire feed Speed (m/min)	Travel Speed (m/min)	Electrode Stick out (mm)	Gas flow (l/min)
Front side	Back Side							
single	single	4	450-500	28-30	controlled by current	0.50-0.55	15-20	N.A

- 10.2 Welding sequence :

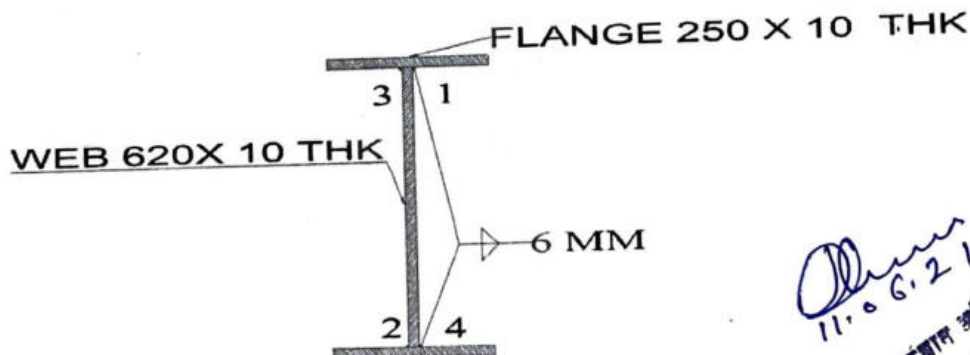

11. Provision of running & run off tabs : Yes
12. Cleaning of weld bead before laying next weld bead : N.A.
13. Root preparation before welding other side of groove weld : N.A.
14. Preheating & interpass temperature : Min-150°C , Interpass Max- 250°C
15. Peening : N.A.
16. Post weld treatment : N.A.
17. Rectification of weld defects : By grinding of the defective weld & rectifying the weld as per Cl 32.2 of IS 9595-96, using A3 class of electrodes of specn IRS M.28-12 after conducting D P test.
18. Inspection of weld : Visually, D.P Test & Macro Etching

Signature
11.06.21
Assistant Research Officer (Met)
Research Officer (Met)
Research Officer (Met)

7/65

91.4M OWG (25T LOADING)

Welding Procedure Specification Sheet (WPSS)

Name and Address of Fabricator

M/s M.G. Contractors Pvt. Ltd.,
Vill- Gola, Kalpi-Naraingarh Road,
Opposite E-max Education City,
Mullana, Ambala (HR) 133104
MGCP/20-21/DFCCIL/SSM-RFO/91.4M/GMAW/WPSS-25

Welding procedure specification No.

1. Drawing No.

: RDSO/B-17184
DETAILS OF TOP LAT. BRACING

2. Weld joint description

: WEB(12 MM) WITH FLANGE (12 MM) FILLET WELD (6 MM)

3. Base metal

: IS:2062 : 2011 E 350 Quality -B0

4. Welding process

: GMAW SAW *de*

5. Welding position

: Horizontal-Vertical, FLAT *de*

6. Welding consumables

: Class: ~~CLASS 1 of IRS M-46~~ W2 of IRS: M-39 *de*

6.1 Electrode/wire - Electrode

Type: Copper coated solid wire

Dia: 1.2 mm (copper coated)

6.2 Flux

Drying Method: N.A

Class: ~~N.A~~ F2 of IRS: M-39 *de*

Type: ~~N.A~~ Agglomerated *de*

Drying Method: N.A. 250-300°C for 2 hours. *de*

6.3 Shielding gas

: CO2


7.0 Base metal preparation

: Fusion faces and adjacent surfaces are cleaned and made free from cracks, notches, mill scale, grease, paint, rust etc., which might affect weld quality.

7.1 Joint design details

: Sketch showing arrangements of parts, weld groove details, weld passes & their sequence etc.

Signature
11.06.21
असिस्टन्ट रिसर्च ऑफिसर (मस)
Assistant Research Officer (Met)
रिसर्च डिवीजन, रेलवे मंत्रालय, नई दिल्ली

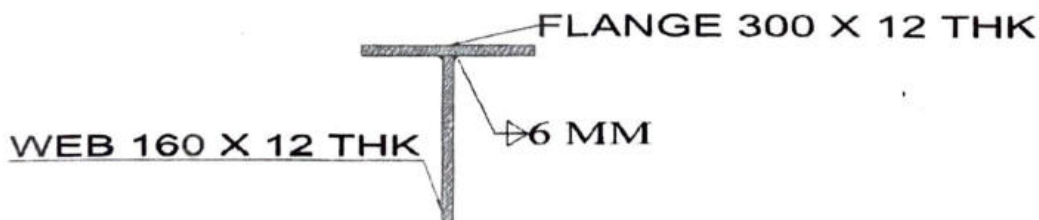

7.2 Joint preparation

As per IS 10178- 1995, Cl. 7, IRS B1 - 2001, Cl. 17.3, & WBC- 2001




7/66

91.4M OWG (25T LOADING)

- 8 Welding current : Type : DC
Polarity: Reverse
- 9 Welder qualification : First welder As per IS-7307(part-I) first welder at all test
then other welder As per IS 7310 (Part I) – 1974
10. Welding parameters and technique :
- 10.1 Welding parameter :

Weld Pass		Electrodes/ Wire dia. (mm)	Current Amp.	Arc Voltage (volt)	Wire feed Speed (m/min)	Travel Speed (m/min)	Electrode Stick out (mm)	Gas flow (l/min)
Front side	Back Side							
single	single	4.0	180-220 50-500	22-26 28-30	controlled by current	N.A. 0.50-0.55	12-15 15-20	15-20 N.A.

- 10.2 Welding sequence :

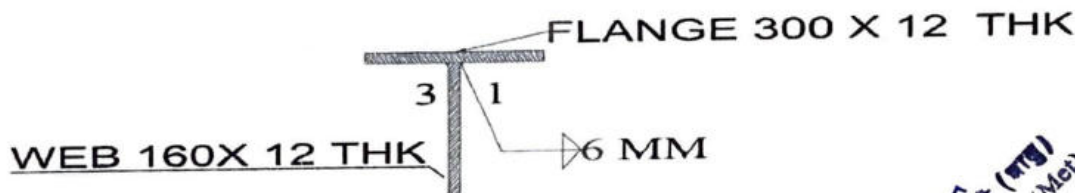

11. Provision of running & run off tabs : Yes
12. Cleaning of weld bead before laying next weld bead : N.A.
13. Root preparation before welding other side of groove weld : N.A.
14. Preheating & interpass temperature : Min-75°C , Interpass Max- 250°C
15. Peening : N.A.
16. Post weld treatment : N.A.
17. Rectification of weld defects : By grinding of the defective weld & rectifying the weld as per CI 32.2 of IS 9595-96, using A3 class of electrodes of specn IRS M.28 after conducting D P test.
18. Inspection of weld : Visually, D.P.Test & Macro Etching

11.06.2016
 Assistant Research Officer (Met)
 Research Officer (Met)
 Research Officer (Met)

7/67

91.4M OWG (25T LOADING)

Welding Procedure Specification Sheet (WPSS)


Name and Address of Fabricator

: M/s M.G.Contractors Pvt. Ltd ,
Vill- Gola, Kalpi-Naraingarh Road,
Opposite E-max Education City,
Mullana, Ambala (HR) 133104
MGCPL/20-21/DFCCIL/SSM-RFO/91.4M/SAW/WPSS-027

Welding procedure specification No.

- | | | | |
|-----|----------------------------|----------------|---|
| 1. | Drawing No. | : | RDSO/B-17184/4/1 (L0-L1-L2)
BATTEN & DIAPHRAGM WELDING OF BOTTOM CHORD |
| 2. | Weld joint description | : | L0-L1-L2
WEB(16 MM) + DIAPHRAGM PLATE (10MM)
FLANGE (12MM) +BATTEN PLATE(10MM) |
| 3. | Base metal | : | IS:2062 : 2011 E 350 Quality -B0 |
| 4. | Welding process | : | GMAW |
| 5. | Welding position | : | Horizontal-Vertical |
| 6. | Welding consumables | : | |
| 6.1 | Electrode/wire – Electrode | Class: | Class-I of IRS M.46 |
| | | Type: | Copper coated solid wire |
| | | Dia: | 1.2 mm (copper coated) |
| | | Drying Method: | N.A |
| 6.2 | Flux | Class: | N.A. |
| | | Type: | N.A. |
| | | Drying Method: | N.A. |
| 6.3 | Shielding gas | : | CO2 |
| 7.0 | Base metal preparation | : | Fusion faces and adjacent surfaces are cleaned and made free from cracks, notches, mill scale, grease, paint, rust etc., which might affect weld quality. |
| 7.1 | Joint design details | : | Sketch showing arrangements of parts, weld groove details, weld passes & their sequence etc. |

11.06.2017
Dr. M. G. Contractor
Assistant Research Officer (Met)
डॉ. म. ग. कंठार

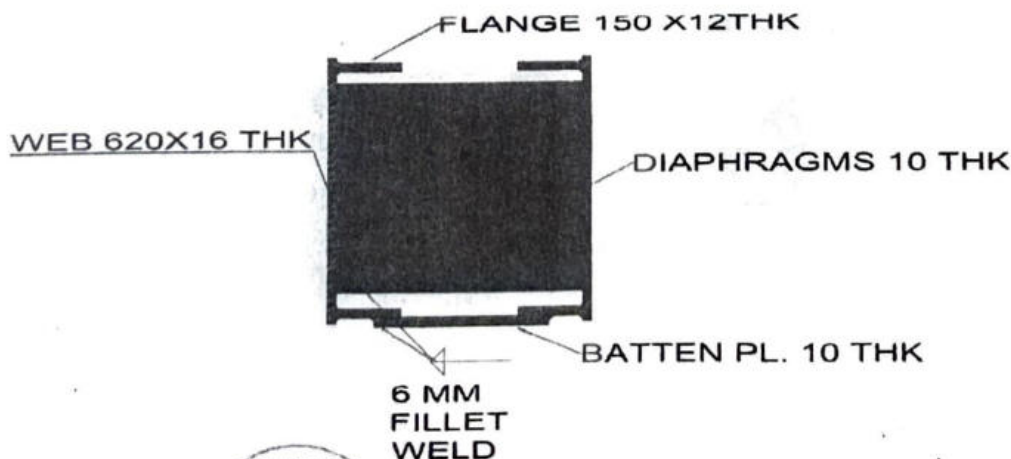

7.2

Joint preparation



उप मुख्य परियोजना प्रबंधक

As per IS 10178, Cl. 7, IRS B1 – 2001, Cl. 17.3, & WBC - 2001

7/68

91.4M OWG (25T LOADING)

8. Welding current : Type : DC
Polarity: Reverse
9. Welder qualification : First welder as per IS-7307(Part-I) First welder at all test then other welder As per IS 7310 (Part I) – 1974
10. Welding parameters and technique :
- 10.1 Welding parameter :

Weld Pass		Electrodes/ Wire dia. (mm)	Current Amp.	Arc Voltage (volt)	Wire feed Speed (m/min)	Travel Speed (m/min)	Electrode Stick out (mm)	Gas flow (l/min)
Front side	Back Side							
	single	1.2MM	180-220	22-26	controlled by current	N.A.	12-15	15-20

- 10.2 Welding sequence :

11. Provision of running & run off tabs : N.A.
12. Cleaning of weld bead before laying next weld bead : N.A.
13. Root preparation before welding other side of groove weld : N.A.
14. Preheating & interpass temperature : Min-75°C , Interpass Max- 250°C
15. Peening : N.A.
16. Post weld treatment : N.A.
17. Rectification of weld defects : By grinding of the defective weld & rectifying the weld as per CI 32.2 of IS 9595-96, using A3 class of electrodes of specn IRS M.28-12 after conducting D P test.
18. Inspection of weld : Visually, D.P. Test & Macro Etching

11.06.21
 Assistant Research Officer (Met.)
 Dr. B. K. Singh
 Dr. B. K. Singh

7/69

91.4M OWG (25T LOADING)

Welding Procedure Specification Sheet (WPSS)

Name and Address of Fabricator


M/s M.G Contractors Pvt. Ltd.,
Vill- Gola, Kalpi-Naraingarh Road,
Opposite E-max Education City,
Mullana, Ambala (HR) 133104

Welding procedure specification No.

MGCPL/20-21/DFCCIL/SSM-RFO/91.4M/SAW/WPSS-028

- | | | | |
|-----|----------------------------|---|---|
| 1. | Drawing No. | : | RDSO/B-17184/4/1 (L2-L3-L4)
BATTEN & DIAPHRAGM WELDING OF BOTTOM CHORD |
| 2. | Weld joint description | : | L2-L3-L4
WEB(20 MM) + DIAPHRAGM PLATE (10MM)
FLANGE (16MM) +BATTEN PLATE(10MM) |
| 3. | Base metal | : | IS:2062 : 2011 E 350 Quality -B0 |
| 4. | Welding process | : | GMAW |
| 5. | Welding position | : | Horizontal-Vertical |
| 6. | Welding consumables | : | |
| 6.1 | Electrode/wire – Electrode | : | Class: Class-I of IRS M 46
Type: Copper coated solid wire
Dia: 1.2 mm (copper coated)
Drying Method: N.A. |
| 6.2 | Flux | : | Class. N.A.
Type: N.A.
Drying Method: N.A. |
| 6.3 | Shielding gas | : | CO2 |
| 7.0 | Base metal preparation | : | Fusion faces and adjacent surfaces are cleaned and made free from cracks, notches, mill scale, grease, paint, rust etc., which might affect weld quality. |
| 7.1 | Joint design details | : | Sketch showing arrangements of parts, weld groove details, weld passes & their sequence etc. |

Signature
11.06.21
Assistant Research Officer (Met)
RDSO, Secy. Bhopal

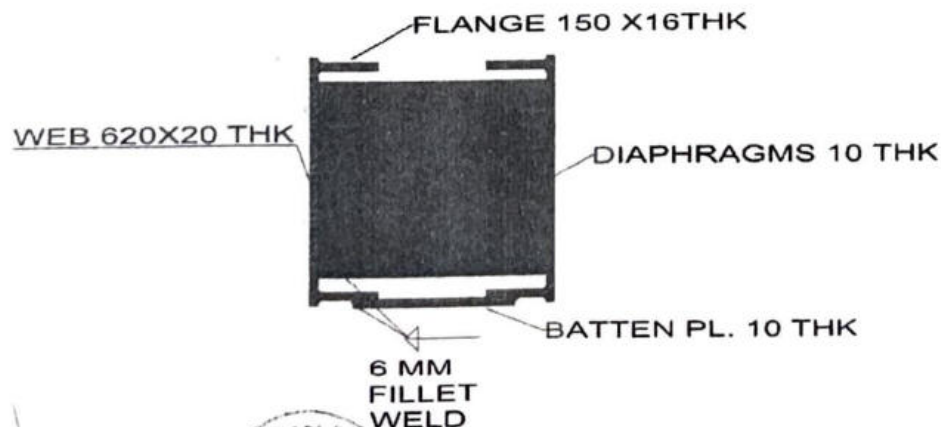

7/70

91.4M OWG (25T LOADING)

8. Welding current : Type : DC
Polarity: Reverse
9. Welder qualification : First welder as per IS-7307(Part-I) First welder at all test then other welder As per IS 7310 (Part I) – 1974
10. Welding parameters and technique :
- 10.1 Welding parameter :

Weld Pass		Electrodes/ Wire dia. (mm)	Current Amp.	Arc Voltage (volt)	Wire feed Speed (m/min)	Travel Speed (m/min)	Electrode Stick out (mm)	Gas flow (l/min)
Front side	Back Side							
	single	1.2MM	180-220	22-26	controlled by current	N.A.	12-15	15-20

- 10.2 Welding sequence :

11. Provision of running & run off tabs : N.A.
12. Cleaning of weld bead before laying next weld bead : N.A.
13. Root preparation before welding other side of groove weld : N.A.
14. Preheating & interpass temperature : Min-75°C , Interpass Max- 250°C
15. Peening : N.A.
16. Post weld treatment : N.A.
17. Rectification of weld defects : By grinding of the defective weld & rectifying the weld as per CI 32.2 of IS 9595-96, using A3 class of electrodes of specn IRS M.28 after conducting D P test.
18. Inspection of weld : Visually, D.P.Test & Macro Etching

11.06.21
 Assistant Research Officer (Met)

7/71

91.4M OWG (25T LOADING)

Welding Procedure Specification Sheet (WPSS)

Name and Address of Fabricator

M/s M.G Contractors Pvt. Ltd.,
Vill- Gola, Kalpi-Naraingarh Road,
Opposite E-max Education City,
Mullana, Ambala (HR) 133104
MGCPL/20-21/DFCCIL/SSM-RFO/91.4M/SAW/WPSS-029

Welding procedure specification No.

1. Drawing No.

RDSO/B-17184/4/2 (L4-L5-L6)
BATTEN & DIAPHRAGM WELDING OF BOTTOM CHORD

2. Weld joint description

L4-L5-L6
WEB(25 MM) + DIAPHRAGM PLATE (10MM)
FLANGE (20MM) +BATTEN PLATE(10MM)

3. Base metal

IS:2062 : 2011 E 350 Quality -B0

4. Welding process

GMAW

5. Welding position

Horizontal-Vertical

6. Welding consumables

6.1 Electrode/wire – Electrode

Class: Class-I of IRS M.46
Type: Copper coated solid wire
Dia: 1.2 mm (copper coated)

6.2 Flux

Drying Method: N.A.
Class: N.A.
Type: N.A.
Drying Method: N.A.

6.3 Shielding gas


CO2

7.0 Base metal preparation

Fusion faces and adjacent surfaces are cleaned and made free from cracks, notches, mill scale, grease, paint, rust etc., which might affect weld quality.

7.1 Joint design details

Sketch showing arrangements of parts, weld groove details, weld passes & their sequence etc.

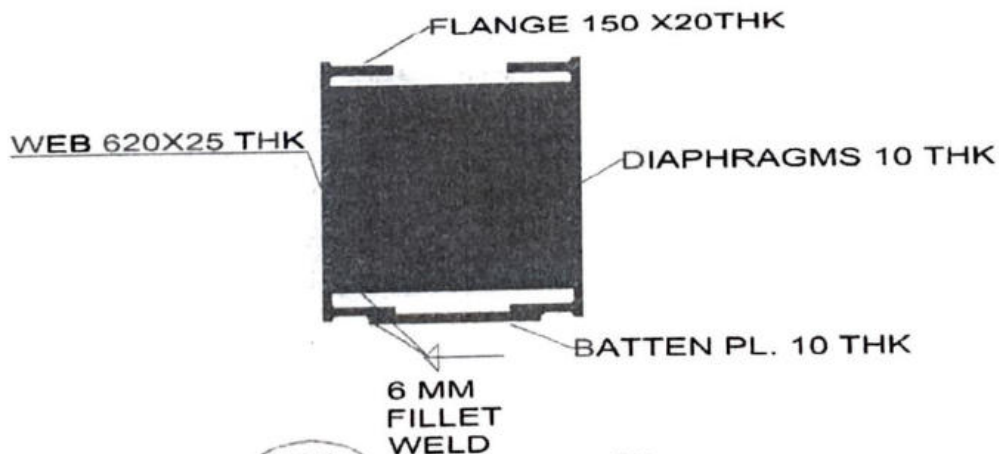

7.2

Joint preparation



As per IS 10178, Cl. 7, IRS'B1 – 2001, Cl. 17.3, & WBC - 2001

27/72

91.4M OWG (25T LOADING)

8. Welding current : Type : DC
Polarity: Reverse
9. Welder qualification : First welder as per IS-7307(Part-I) First welder at all test then other welder As per IS 7310 (Part I) – 1974
10. Welding parameters and technique :
- 10.1 Welding parameter :

Weld Pass		Electrodes/ Wire dia. (mm)	Current Amp.	Arc Voltage (volt)	Wire feed Speed (m/min)	Travel Speed (m/min)	Electrode Stick out (mm)	Gas flow (l/min)
Front side	Back Side							
	single	1.2MM	180-220	22-26	controlled by current	N.A.	12-15	15-20

- 10.2 Welding sequence :

11. Provision of running & run off tabs : N.A.
12. Cleaning of weld bead before laying next weld bead : N.A.
13. Root preparation before welding other side of groove weld : N.A.
14. Preheating & interpass temperature : Min-75°C , Interpass Max- 250°C
15. Peening : N.A.
16. Post weld treatment : N.A.
17. Rectification of weld defects : By grinding of the defective weld & rectifying the weld as per CI 32.2 of IS 9595-96, using A3 class of electrodes of specn IRS M.28 after conducting D P test.
18. Inspection of weld : Visually, D.P.Test & Macro Etching

11-06-21
 Assistant Research Officer (Met)
 Research Officer (Met)


7/73

91.4M OWG (25T LOADING)

Welding Procedure Specification Sheet (WPSS)

Name and Address of Fabricator	M/s M.G Contractors Pvt. Ltd., Vill- Gola, Kalpi-Naraingarh Road, Opposite E-max Education City, Mullana, Ambala (HR) 133104
Welding procedure specification No.	MGCPL/20-21/DFCCIL/SSM-RFO/91.4M/SAW/WPSS-030
1. Drawing No.	RDSO/B-17184/4/2 (L6-L7) BATTEN & DIAPHRAGM WELDING OF BOTTOM CHORD
2. Weld joint description	L6-L7 WEB(25 MM) + DIAPHRAGM PLATE (10MM) FLANGE (25MM) +BATTEN PLATE(10MM)
3. Base metal	IS:2062 : 2011 E 350 Quality -B0
4. Welding process	GMAW
5. Welding position	Horizontal-Vertical
6. Welding consumables	
6.1 Electrode/wire – Electrode	Class: Class-I of IRS M.46 Type: Copper coated solid wire Dia: 1.2 mm (copper coated) Drying Method: N.A
6.2 Flux	Class: N.A. Type: : N.A. Drying Method. N.A.
6.3 Shielding gas	CO2
7.0 Base metal preparation	Fusion faces and adjacent surfaces are cleaned and made free from cracks, notches, mill scale, grease, paint, rust etc., which might affect weld quality.
7.1 Joint design details	Sketch showing arrangements of parts, weld groove details, weld passes & their sequence etc.

Signature
11.06.21
सहायक अनुसंधान अधिकारी (धातु)
Assistant Research Officer (Met)
भारतीय रेलवे कक्षा-1

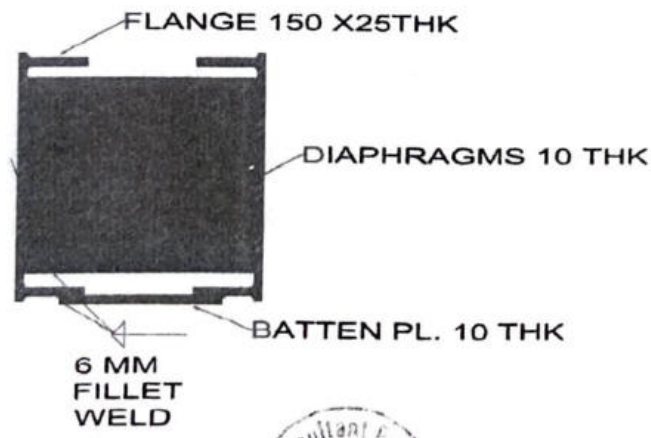

7.2 Joint preparation



7/74

91.4M OWG (25T LOADING)

8. Welding current : Type : DC
Polarity: Reverse
9. Welder qualification : First welder as per IS-7307(Part-I) First welder at all test then other welder As per IS 7310 (Part I) – 1974
10. Welding parameters and technique :
- 10.1 Welding parameter :

Weld Pass		Electrodes/ Wire dia. (mm)	Current Amp.	Arc Voltage (volt)	Wire feed Speed (m/min)	Travel Speed (m/min)	Electrode Stick out (mm)	Gas flow (l/min)
Front side	Back Side							
	single	1.2MM	180-220	22-26	controlled by current	N.A.	12-15	15-20

- 10.2 Welding sequence :

11. Provision of running & run off tabs : N.A.
12. Cleaning of weld bead before laying next weld bead : N.A.
13. Root preparation before welding other side of groove weld : N.A.
14. Preheating & interpass temperature : Min-75°C , Interpass Max- 250°C
15. Peening : N.A.
16. Post weld treatment : N.A.
17. Rectification of weld defects : By grinding of the defective weld & rectifying the weld as per CI 32.2 of IS 9595-96, using A3 class of electrodes of specn IRS M.28-12 after conducting D P test.
18. Inspection of weld : Visually, D.P. Test & Macro Etching

11.06.21
 Assistant Research Officer (Met)
 Research Officer (Met)

7/75

91.4M OWG (25T LOADING)

Welding Procedure Specification Sheet (WPSS)


Name and Address of Fabricator

M/s M.G Contractors Pvt. Ltd.,
Vill- Gola, Kalpi-Naraingarh Road,
Opposite E-max Education City,
Mullana, Ambala (HR) 133104
MGCP/20-21/DFCCIL/SSM-RFO/91.4M/SAW/WPSS-031

Welding procedure specification No.

1. Drawing No. : RDSO/B-17184/5/1
LACING, BATTEN & DIAPHRAGM WELDING OF TOP CHORD
2. Weld joint description : U0-U1-U2
WEB(10 MM) + DIAPHRAGM PLATE (10MM)
FLANGE (16MM) +BATTEN PLATE(10MM)
FLANGE (16MM)+LACING PLATE (16MM)
3. Base metal : IS:2062 : 2011 E 350 Quality -B0
4. Welding process : GMAW
5. Welding position : Horizontal-Vertical
6. Welding consumables :
6.1 Electrode/wire – Electrode : Class: Class-I of IRS M.46
Type: Copper coated solid wire
Dia: 1.2 mm (copper coated)
Drying Method: N.A.
- 6.2 Flux : Class: N.A.
Type: : N.A.
Drying Method: N.A.
- 6.3 Shielding gas : CO2
- 7.0 Base metal preparation : Fusion faces and adjacent surfaces are cleaned and made free from cracks, notches, mill scale, grease, paint, rust etc., which might affect weld quality.
- 7.1 Joint design details : Sketch showing arrangements of parts, weld groove details, weld passes & their sequence etc.

Signature
11.06.21
Assistant Research Officer (M&S)

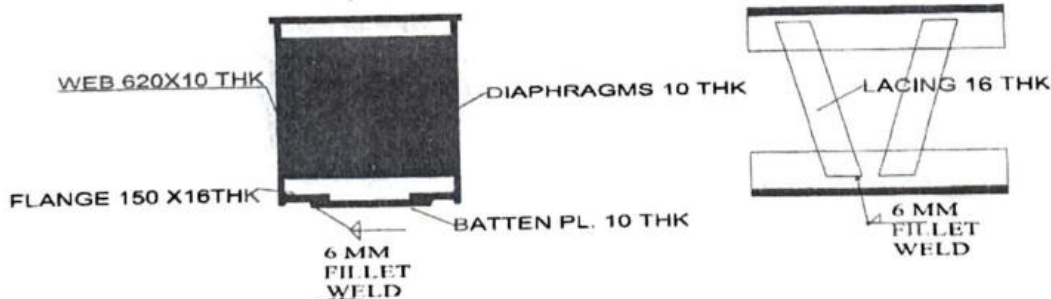

7/76

91.4M OWG (25T LOADING)

- 7.2 Joint preparation : As per IS 10178, Cl. 7, IRS B1 – 2001, Cl. 17.3, & WBC - 2001
8. Welding current : Type : DC
Polarity: Reverse
9. Welder qualification : First welder as per IS-7307(Part-I) First welder at all test then other welder As per IS 7310 (Part I) – 1974
10. Welding parameters and technique :
- 10.1 Welding parameter :

Weld Pass		Electrodes/ Wire dia. (mm)	Current Amp.	Arc Voltage (volt)	Wire feed Speed (m/min)	Travel Speed (m/min)	Electrode Stick out (mm)	Gas flow (l/min)
Front side	Back Side							
	single	1.2MM	180-220	22-26	controlled by current	N.A.	12-15	15-20

- 10.2 Welding sequence :

11. Provision of running & run off tabs : N.A.
12. Cleaning of weld bead before laying next weld bead : N.A.
13. Root preparation before welding other side of groove weld : N.A.
14. Preheating & interpass temperature : Min-75°C , Interpass Max- 250°C
15. Peening : N.A
16. Post weld treatment : N.A.
17. Rectification of weld defects : By grinding of the defective weld & rectifying the weld as per Cl 32.2 of IS 9595-96, using A3 class of electrodes of specn IRS M.28 after conducting D P test.
18. Inspection of weld : Visually, D.P.Test & Macro Etching

[Signature]
11.06.21
Asst. Research Officer (Met)
Raj. Res. Lab. Bhopal-462011

7/22

91.4M OWG (25T LOADING)


Welding Procedure Specification Sheet (WPSS)

Name and Address of Fabricator

M/s M G Contractors Pvt. Ltd.,
Vill- Gola, Kalpi-Naraingarh Road,
Opposite E-max Education City,
Mullana, Ambala (HR) 133104
MGCP/20-21/DFCCIL/SSM-RFO/91.4M/SAW/WPSS-032

Welding procedure specification No.

1. Drawing No. : RDSO/B-17184/5/1
LACING BATTEN & DIAPHRAGM WELDING OF TOP CHORD
2. Weld joint description : U2-U3-U4
WEB(25 MM) + DIAPHRAGM PLATE (10MM)
FLANGE (16MM) +BATTEN PLATE(10MM)
FLANGE (16MM)+LACING PLATE (16MM)
3. Base metal : IS:2062 : 2011 E 350 Quality -B0
4. Welding process : GMAW
5. Welding position : Horizontal-Vertical
- 7.1 Joint design details

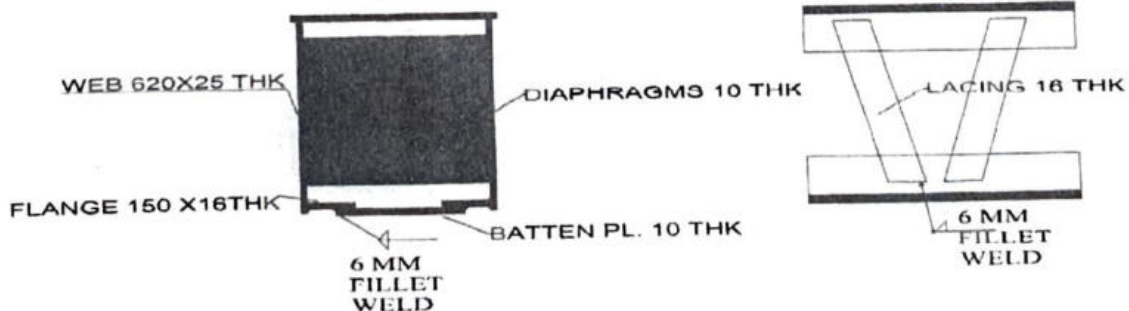

Consultant Firm

उप मुख्य परीक्षक / सचिव

2/78

- | Weld Pass | | Electrodes/
Wire dia.
(mm) | Current
Amp. | Arc Voltage
(volt) | Wire feed
Speed
(m/min) | Travel
Speed
(m/min) | Electrode
Stick out
(mm) | Gas flow
(l/min) |
|---------------|--------------|----------------------------------|-----------------|-----------------------|-------------------------------|----------------------------|--------------------------------|---------------------|
| Front
side | Back
Side | | | | | | | |
| | single | 1.2MM | 180-220 | 22-26 | controlled by
current | N.A. | 12-15 | 15-20 |

- | | | | |
|-----|---|---|------|
| 11. | Provision of running & run off tabs | : | N.A. |
| 12. | Cleaning of weld bead before laying next weld bead | : | N.A. |
| 13. | Root preparation before welding other side of groove weld | : | N.A. |
| 14. | Preheating & interpass temperature | : | Min- |
| 15. | Peening | : | N.A. |
| 16. | Post weld treatment | : | N.A. |
| 17. | Rectification of weld defects | : | By |


- 11.06.21
 Assistant Research Officer (Met)
 रेल मन्त्रालय, बल्लभपुर-11

7/79

91.4M OWG (25T LOADING)

Welding Procedure Specification Sheet (WPSS)

Name and Address of Fabricator	: M/s M.G.Contractors Pvt. Ltd., Vill- Gola, Kalpi-Naraingarh Road, Opposite E-max Education City, Mullana, Ambala (HR) 133104		
Welding procedure specification No.	MGCP/20-21/DFCCIL/SSM-RFO/91.4M/SAW/WPSS-033		
1. Drawing No.	: RDSO/B-17184/5/2	LACING, BATTEN & DIAPHRAGM WELDING OF TOP CHORD	
2. Weld joint description	: U4-U5-U6	WEB(32 MM) + DIAPHRAGM PLATE (10MM) FLANGE (20MM) +BATTEN PLATE(10MM) FLANGE (20MM)+LACING PLATE (16MM)	
3. Base metal	: IS:2062 : 2011 E 350	Quality -B0	
4. Welding process	: GMAW		
5. Welding position	: Horizontal-Vertical		
6. Welding consumables	:		
6.1 Electrode/wire – Electrode	: Class:	Class-I of IRS M 46	
	Type:	Copper coated solid wire	
	Dia:	1.2 mm (copper coated)	
	Drying Method:	N.A	
6.2 Flux	: Class:	N.A.	
	Type:	N.A.	
	Drying Method:	N.A.	
6.3 Shielding gas	: CO2		
7.0 Base metal preparation	: Fusion faces and adjacent surfaces are cleaned and made free from cracks, notches, mill scale, grease, paint, rust etc., which might affect weld quality.		
7.1 Joint design details	: Sketch showing arrangements of parts, weld groove details, weld passes & their sequence etc.		

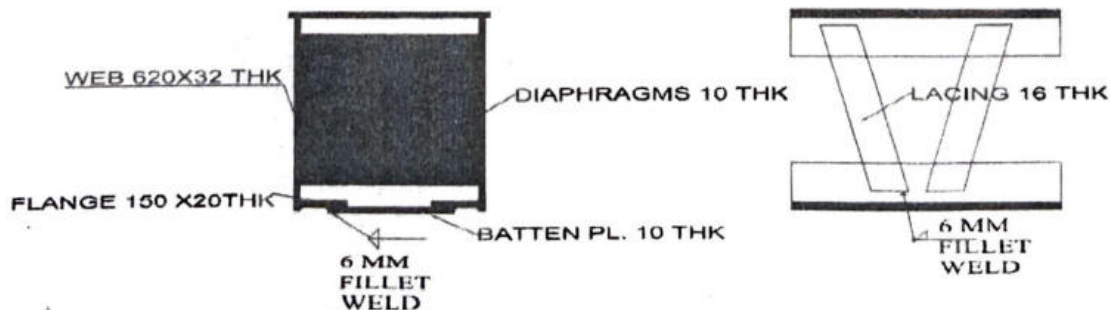

91.4M OWG (25T LOADING)

- | | | | |
|------|----------------------------------|---|---|
| 7.2 | Joint preparation | : | As per IS 10178, Cl. 7, IRS B1 – 2001, Cl. 17.3, & WBC - 2001 |
| 8. | Welding current | : | Type : DC
Polarity: Reverse |
| 9. | Welder qualification | : | First welder as per IS-7307(Part-I) First welder at all test then other welder As per IS 7310 (Part I) – 1974 |
| 10. | Welding parameters and technique | : | |
| 10.1 | Welding parameter | : | |

Weld Pass		Electrodes/ Wire dia. (mm)	Current Amp.	Arc Voltage (volt)	Wire feed Speed (m/min)	Travel Speed (m/min)	Electrode Stick out (mm)	Gas flow (l/min)
Front side	Back Side							
	single	1.2MM	180-220	22-26	controlled by current	N.A.	12-15	15-20

- ## 10.2 Welding sequence

- | | | | |
|-----|---|---|---|
| 11. | Provision of running & run off tabs | : | N.A. |
| 12. | Cleaning of weld bead before laying next weld bead | : | N.A. |
| 13. | Root preparation before welding other side of groove weld | : | N.A. |
| 14. | Preheating & interpass temperature | : | Min-75°C , Interpass Max- 250°C |
| 15. | Peening | : | N.A |
| 16. | Post weld treatment | : | N.A. |
| 17. | Rectification of weld defects | : | By grinding of the defective weld & rectifying the weld as per Cl 32.2 of IS 9595-96, using A3 class of electrodes of specn IRS M 28 after conducting D P test. |
| 18. | Inspection of weld | : | Visually, D.P.Test & Macro Etching |

11-06-21
 बालक अनुसंधान अधिकारी (बाल)
 Assistant Research Officer (Met)

7/81

91.4M OWG (25T LOADING)

Welding Procedure Specification Sheet (WPSS)


Name and Address of Fabricator

M/s M.G. Contractors Pvt. Ltd.,
Vill- Gola, Kalpi-Naraingarh Road,
Opposite E-max Education City,
Mullana, Ambala (HR) 133104
MGCP/20-21/DFCCIL/SSM-RFO/91.4M/SAW/WPSS-034

Welding procedure specification No.

- | | | | |
|-----|----------------------------|---|--|
| 1. | Drawing No. | : | RDSO/B-17184/5/2
LACING BATTEN & DIAPHRAGM WELDING OF TOP CHORD |
| 2. | Weld joint description | : | U6-U7
WEB(32 MM) + DIAPHRAGM PLATE (10MM)
FLANGE (32MM) +BATTEN PLATE(10MM)
FLANGE (32MM)+LACING PLATE (16MM) |
| 3. | Base metal | : | IS:2062 : 2011 E 350 Quality -B0 |
| 4. | Welding process | : | GMAW |
| 5. | Welding position | : | Horizontal-Vertical |
| 6. | Welding consumables | : | |
| 6.1 | Electrode/wire – Electrode | : | Class: Class-I of IRS M.46
Type: Copper coated solid wire
Dia: 1.2 mm (copper coated)
Drying Method: N.A. |
| 6.2 | Flux | : | Class: N.A.
Type: N.A.
Drying Method: N.A. |
| 6.3 | Shielding gas | : | CO2 |
| 7.0 | Base metal preparation | : | Fusion faces and adjacent surfaces are cleaned and made free from cracks, notches, mill scale, grease, paint, rust etc, which might affect weld quality. |
| 7.1 | Joint design details | : | Sketch showing arrangements of parts, weld groove details, weld passes & their sequence etc. |

(Signature)
Assistant Research Officer (Met)
RDSO, Ambala

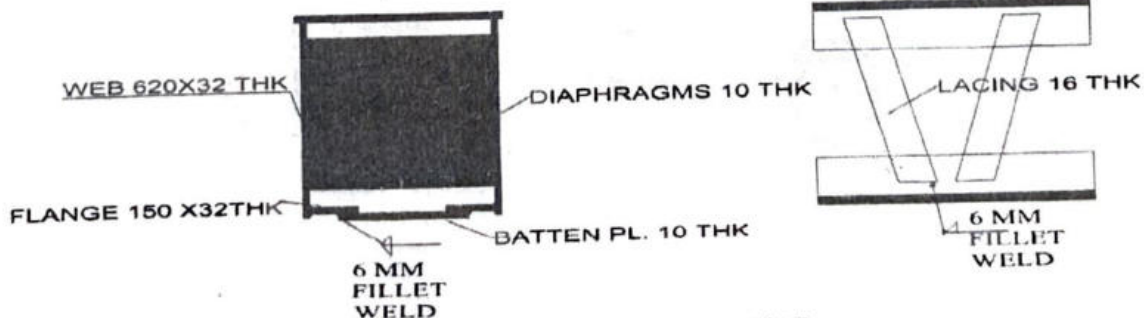

परियोजना प्रबंधक

7/82

91.4M OWG (25T LOADING)

- 7.2 Joint preparation : As per IS 10178, Cl. 7, IRS B1 – 2001, Cl. 17.3, & WBC - 2001
8. Welding current : Type : DC
Polarity: Reverse
9. Welder qualification : First welder as per IS-7307(Part-I) First welder at all test then other welder As per IS 7310 (Part I) – 1974
10. Welding parameters and technique :
- 10.1 Welding parameter :

Weld Pass		Electrodes/ Wire dia. (mm)	Current Amp.	Arc Voltage (volt)	Wire feed Speed (m/min)	Travel Speed (m/min)	Electrode Stick out (mm)	Gas flow (l/min)
Front side	Back Side							
	single	1.2MM	180-220	22-26	controlled by current	N.A.	12-15	15-20

- 10.2 Welding sequence :

11. Provision of running & run off tabs : N.A.
12. Cleaning of weld bead before laying next weld bead : N.A.
13. Root preparation before welding other side of groove weld : N.A.
14. Preheating & interpass temperature : Min-75°C , Interpass Max- 250°C
15. Peening : N A
16. Post weld treatment : N.A.
17. Rectification of weld defects : By grinding of the defective weld & rectifying the weld as per Cl 32.2 of IS 9595-96, using A3 class of electrodes of specn IRS M.28-12 after conducting D P test.
18. Inspection of weld : Visually, D.P.Test & Macro Etching

11-06-21
 Assistant Research Officer (Met)
 Research Officer (Met)

7/83


91.4M OWG (25T LOADING)**Welding Procedure Specification Sheet (WPSS)**

Name and Address of Fabricator

: M/s M.G. Contractors Pvt. Ltd.,
Vill- Gola, Kalpi-Naraingarh Road,
Opposite E-max Education City,
Mullana, Ambala (HR) 133104
MGCP/20-21/DFCCIL/SSM-RFO/91.4M/SAW/WPSS-035

Welding procedure specification No.

1. Drawing No. : RDSO/B-17184/6
LACING BATTEN & DIAPHRAGM WELDING OF END
RAKER
2. Weld joint description : L0-M0-U0
WEB(25 MM) + DIAPHRAGM PLATE (10MM)
FLANGE (20MM) +BATTEN PLATE(10MM)
FLANGE (20MM)+LACING PLATE (16MM)
3. Base metal : IS:2062 : 2011 E 350 Quality -B0
4. Welding process : GMAW
5. Welding position : Horizontal-Vertical
6. Welding consumables :
6.1 Electrode/wire – Electrode : Class: Class-I of IRS M.46
Type: Copper coated solid wire
Dia: 1.2 mm (copper coated)
Drying Method: N.A.
- 6.2 Flux : Class: N.A.
Type: : N.A.
Drying Method: N.A.
- 6.3 Shielding gas : CO2
- 7.0 Base metal preparation : Fusion faces and adjacent surfaces are cleaned and made
free from cracks, notches, mill scale, grease, paint, rust etc.,
which might affect weld quality.
- 7.1 Joint design details : Sketch showing arrangements of parts, weld groove details,
weld passes & their sequence etc.

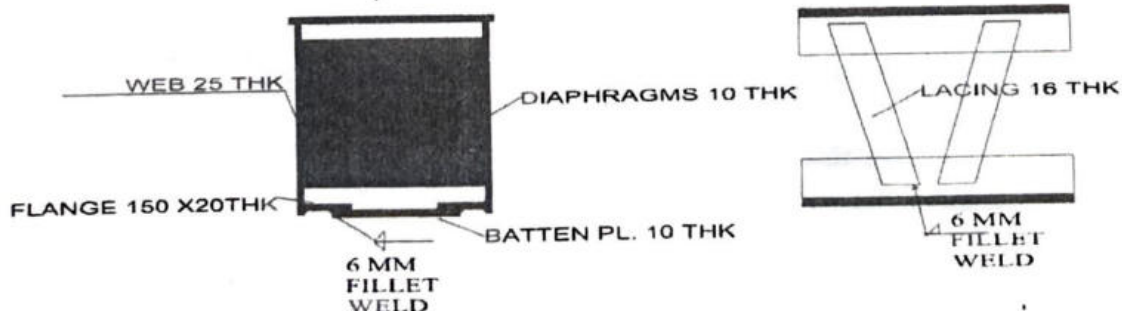

Consultant Private

उप मुख्य परियोजना प्रबंधक
by Chief P. and Manager

7/84

91.4M OWG (25T LOADING)

- 7.2 Joint preparation : As per IS 10178, Cl. 7, IRS B1 – 2001, Cl. 17.3, & WBC - 2001
8. Welding current : Type : DC
Polarity: Reverse
9. Welder qualification : First welder as per IS-7307(Part-I) First welder at all test then other welder As per IS 7310 (Part I) – 1974
10. Welding parameters and technique :
- 10.1 Welding parameter :

Weld Pass		Electrodes/ Wire dia. (mm)	Current Amp.	Arc Voltage (volt)	Wire feed Speed (m/min)	Travel Speed (m/min)	Electrode Stick out (mm)	Gas flow (l/min)
Front side	Back Side							
	single	1.2MM	180-220	22-26	controlled by current	N.A.	12-15	15-20

- 10.2 Welding sequence :

11. Provision of running & run off tabs : N.A.
12. Cleaning of weld bead before laying next weld bead : N.A.
13. Root preparation before welding other side of groove weld : N.A.
14. Preheating & interpass temperature : Min-75°C , Interpass Max- 250°C
15. Peening : N.A.
16. Post weld treatment : N.A.
17. Rectification of weld defects : By grinding of the defective weld & rectifying the weld as per Cl 32.2 of IS 9595-96, using A3 class of electrodes of specn IRS M.28 after conducting D P test.
18. Inspection of weld : Visually, D.P.Test & Macro Etching

11.06.21
 Assistant Research Officer (Met)
 Research Officer (Met)
 Research Officer (Met)

7/85

91.4M OWG (25T LOADING)

Name and Address of Fabricator

M/s M.G Contractors Pvt. Ltd.,
Vill- Gola, Kalpi-Naraingarh Road,
Opposite E-max Education City,
Mullana, Ambala (HR) 133104
MGCPL/20-21/DFCCIL/SSM-RFO/91.4M/SAW/WPSS-036

Welding procedure specification No.

1. Drawing No.

RDSO/B-17184/1 TO 17184/18
BATTEN WELDING OF DIAGONALS

2. Weld joint description

M0-L1, M0-U1
FLANGE (16MM) +BATTEN PLATE(10MM)

3. Base metal

IS:2062 : 2011 E 350 Quality -B0

4. Welding process

GMAW

5. Welding position

Horizontal-Vertical

6. Welding consumables

6.1 Electrode/Wire – Electrode

Class: Class-I of IRS M.46
Type: Copper coated solid wire
Dia: 1.2 mm (copper coated)

Drying Method: N.A

6.2 Flux

Class: N.A.

Type: N.A.

Drying Method: N.A.

6.3 Shielding gas

CO2

7.0 Base metal preparation

Fusion faces and adjacent surfaces are cleaned and made free from cracks, notches, mill scale, grease, paint, rust etc., which might affect weld quality.

7.1 Joint design details

Sketch showing arrangements of parts, weld groove details, weld passes & their sequence etc.

FLANGE 150 X16THK



BATTEN PL. 10 THK

6 MM
FILLET
WELD

7.2 Joint preparation



उप मुख्य As per IS 10178, CI. 7, IRS B1 – 2001, CI 17.3. & WBC - 2001

2/86

91.4M OWG (25T LOADING)

8. Welding current : Type : DC
Polarity: Reverse
9. Welder qualification : First welder as per IS-7307(Part-I) First welder at all test then other welder As per IS 7310 (Part I) – 1974
10. Welding parameters and technique :
- 10.1 Welding parameter :

Weld Pass		Electrodes/ Wire dia. (mm)	Current Amp.	Arc Voltage (volt)	Wire feed Speed (m/min)	Travel Speed (m/min)	Electrode Stick out (mm)	Gas flow (l/min)
Front side	Back Side							
	single	1.2MM	180-220	22-26	controlled by current	N.A.	12-15	15-20

- 10.2 Welding sequence :

11. Provision of running & run off tabs : N.A.
12. Cleaning of weld bead before laying next weld bead : N.A.
13. Root preparation before welding other side of groove weld : N.A.
14. Preheating & interpass temperature : Min-75°C , Interpass Max- 250°C
15. Peening : N.A.
16. Post weld treatment : N.A.
17. Rectification of weld defects : By grinding of the defective weld & rectifying the weld as per Cl 32.2 of IS 9595-96, using A3 class of electrodes of specn IRS M 28 after conducting D P test.
18. Inspection of weld : Visually, D.P.Test & Macro Etching

11.06.21
 Assistant Research Officer (Met)
 रेलवे मंत्रालय, नई दिल्ली-110001

7/87

91.4M OWG (25T LOADING)

Name and Address of Fabricator

M/s M.G. Contractors Pvt. Ltd.,
Vill- Gola, Kalpi-Naraingarh Road,
Opposite E-max Education City,
Mullana, Ambala (HR) 133104
MGCP/20-21/DFCCIL/SSM-RFO/91.4M/SAW/WPSS-037

Welding procedure specification No.

RDSO/B-17184/1 TO 17184/18
BATTEN & LACING WELDING OF DIAGONALS

1. Drawing No.

2. Weld joint description

M1-L2, M2-L3, M3-L4, M4-L5, M5-L6, M6-L7, M1-U2, M2-U3,
M3-U4, M4-U5, M5-U6 & M6-U7
FLANGE (12MM) +BATTEN PLATE(10MM)
FLANGE (12MM) +LACING PLATE(16MM)

3. Base metal

IS:2062 : 2011 E 350 Quality -B0

4. Welding process

GMAW

5. Welding position

Horizontal-Vertical

6. Welding consumables

6.1 Electrode/wire – Electrode

Class:

Class-I of IRS M.46

Type:

Copper coated solid wire

Dia:

1.2 mm (copper coated)

Drying Method:

N.A

6.2 Flux

Class: N.A.

Type: N.A.

Drying Method: N.A.

6.3 Shielding gas



CO2

7.0 Base metal preparation

Fusion faces and adjacent surfaces are cleaned and made free from cracks, notches, mill scale, grease, paint, rust etc., which might affect weld quality.

7.1 Joint design details

Sketch showing arrangements of parts, weld groove details, weld passes & their sequence etc.

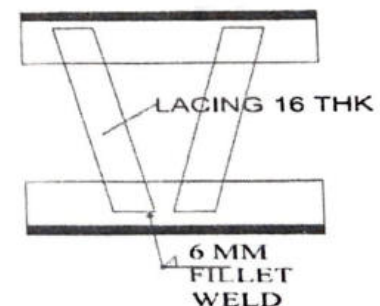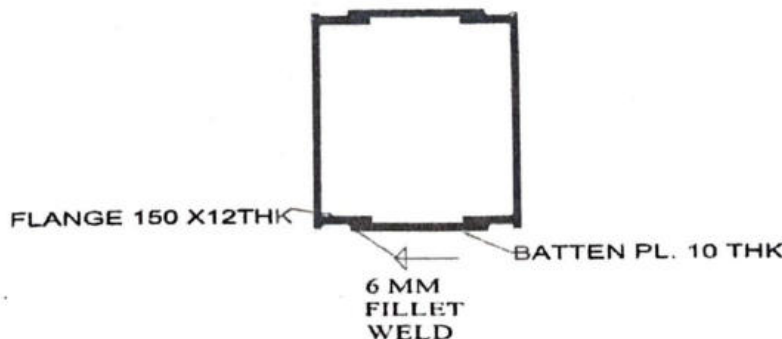

7/88

91.4M OWG (25T LOADING)

- 7.2 Joint preparation : As per IS 10178, Cl. 7, IRS B1 – 2001, Cl. 17.3, & WBC - 2001
8. Welding current : Type : DC
Polarity: Reverse
9. Welder qualification : First welder as per IS-7307(Part-I) First welder at all test then other welder As per IS 7310 (Part I) – 1974
10. Welding parameters and technique :
- 10.1 Welding parameter :

Weld Pass		Electrodes/ Wire dia. (mm)	Current Amp.	Arc Voltage (volt)	Wire feed Speed (m/min)	Travel Speed (m/min)	Electrode Stick out (mm)	Gas flow (l/min)
Front side	Back Side							
	single	1.2MM	180-220	22-26	controlled by current	N.A.	12-15	15-20

- 10.2 Welding sequence :

11. Provision of running & run off tabs : N.A.
12. Cleaning of weld bead before laying next weld bead : N.A.
13. Root preparation before welding other side of groove weld : N.A.
14. Preheating & interpass temperature : Min-75°C , Interpass Max- 250°C
15. Peening : N.A.
16. Post weld treatment : N.A.
17. Rectification of weld defects : By grinding of the defective weld & rectifying the weld as per Cl 32.2 of IS 9595-96, using A3 class of electrodes of specn IRS M.28-12 after conducting D P test.
18. Inspection of weld : Visually, D.P.Test & Macro Etching

11.06.21

असिस्टन्ट अनुसंधान अधिकारी (मल्टी)
Assistant Research Officer (Met)
भारतीय रेलवे मंत्रालय बल्लार-11

7/89

91.4M OWG (25T LOADING)

Name and Address of Fabricator



M/s M.G Contractors Pvt. Ltd.,
Vill- Gola, Kalpi-Naraingarh Road,
Opposite E-max Education City,
Mullana, Ambala (HR) 133104

Welding procedure specification No.

MGCP/20-21/DFCCIL/SSM-RFO/91.4M/SAW/WPSS-038

1. Drawing No. : RDSO/B-17184/12
END PLATE OF CROSS GIRDER WITH WEB & FLANGE OF CROSS GIRDER
2. Weld joint description : WEB (16MM) +END PLATE (20MM) WELDING -12MM
FLANGE (40MM) +END PLATE(20MM)- WELDING -12MM
3. Base metal : IS.2062 : 2011 E 350 Quality -B0
4. Welding process : GMAW
5. Welding position : Horizontal-Vertical
6. Welding consumables :
 - 6.1 Electrode/wire – Electrode : Class: Class-I of IRS M.46
Type: Copper coated solid wire
Dia: 1.2 mm (copper coated)
Drying Method: N.A.
 - 6.2 Flux : Class: N.A.
Type: N.A.
Drying Method: N.A.
- 6.3 Shielding gas : CO2
- 7.0 Base metal preparation : Fusion faces and adjacent surfaces are cleaned and made free from cracks, notches, mill scale, grease, paint, rust etc., which might affect weld quality.
- 7.1 Joint design details : Sketch showing arrangements of parts, weld groove details, weld passes & their sequence etc.

11.06.21
Dr. Anurag Kumar
Assistant Research Officer (Met)
DRDC, Secy, Noida

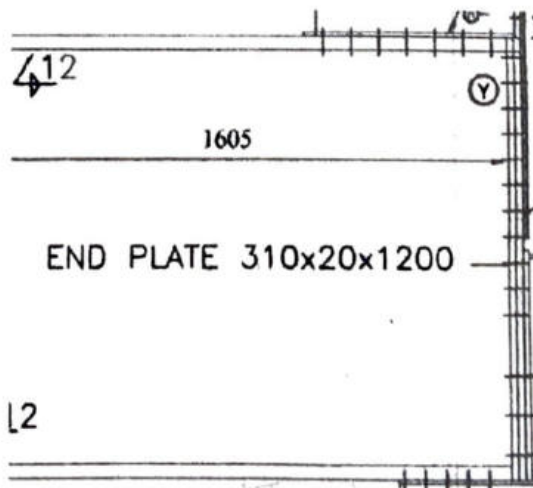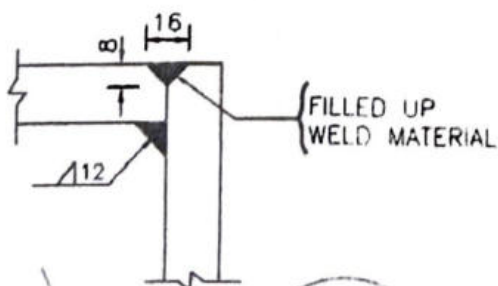

7/90

91.4M OWG (25T LOADING)

- 7.2 Joint preparation : As per IS 10178, Cl. 7, IRS B1 – 2001, Cl. 17.3, & WBC - 2001
8. Welding current : Type : DC
Polarity: Reverse
9. Welder qualification : First welder as per IS-7307(Part-I) First welder at all test then other welder As per IS 7310 (Part I) – 1974
10. Welding parameters and technique :
- 10.1 Welding parameter :

Weld Pass		Electrodes/ Wire dia. (mm)	Current Amp.	Arc Voltage (volt)	Wire feed Speed (m/min)	Travel Speed (m/min)	Electrode Stick out (mm)	Gas flow (l/min)
Front side	Back Side							
	single +	1.2MM	180-220	22-28	controlled by current	N.A.	12-15	15-20

- 10.2 Welding sequence :

11. Provision of running & run off tabs : N.A.
12. Cleaning of weld bead before laying next weld bead : ~~N.A.~~ YES
13. Root preparation before welding other side of groove weld : N.A.
14. Preheating & interpass temperature : Min-75°C , Interpass Max- 250°C
15. Peening : N.A
16. Post weld treatment : N.A.
17. Rectification of weld defects : By grinding of the defective weld & rectifying the weld as per Cl 32.2 of IS 9595-96, using A3 class of electrodes of specn IRS M.28-12 after conducting D P test.
18. Inspection of weld : Visually, D.P.Test & Macro Etching

11.06.21
 Assistant Research Officer (Met)
 Research Officer (Met)
 Research Officer (Met)

7/91

91.4M OWG (25T LOADING)

Name and Address of Fabricator

M/s M.G. Contractors Pvt. Ltd.,
Vill- Gola, Kalpi-Naraingarh Road,
Opposite E-max Education City,
Mullana, Ambala (HR) 133104
MGCP/20-21/DFCCIL/SSM-RFO/91 4M/SAW/WPSS-039

Welding procedure specification No.

RDSO/B-17184/12
END CLEAT OF CROSS-GIRDER

1. Drawing No.

2. Weld joint description

3. Base metal

4. Welding process

5. Welding position

6. Welding consumables

6.1 Electrode/wire - Electrode

WEB (16MM) + FLANGE (16MM)

IS:2062 : 2011 E 350 Quality -B0

GMAW

Horizontal-Vertical

Class: Class-I of IRS M.46

Type: Copper coated solid wire

Dia: 1.2 mm (copper coated)

Drying Method: N.A

Class: N.A.

Type: N.A.

Drying Method: N.A.

6.2 Flux

6.3 Shielding gas


7.0 Base metal preparation

7.1 Joint design details


CO2

Fusion faces and adjacent surfaces are cleaned and made free from cracks, notches, mill scale, grease, paint, rust etc., which might affect weld quality.

Sketch showing arrangements of parts, weld groove details, weld passes & their sequence etc.

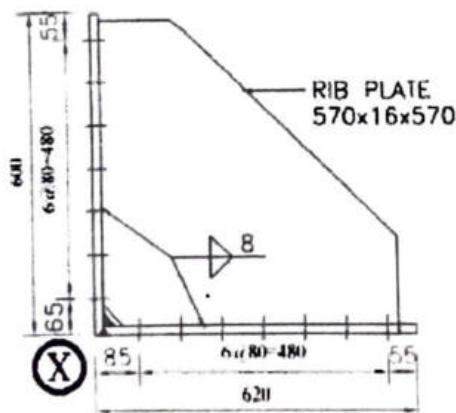

DETAIL AT 'H'

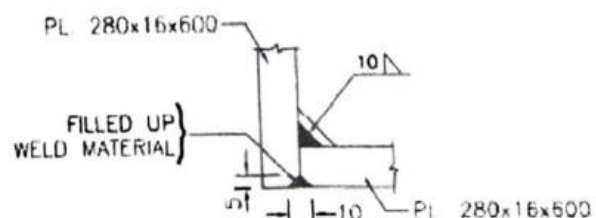

DETAIL AT 'X'

7/92

91.4M OWG (25T LOADING)

- 7.2 Joint preparation : As per IS 10178, Cl. 7, IRS B1 – 2001, Cl. 17.3, & WBC - 2001
8. Welding current : Type : DC
Polarity: Reverse
9. Welder qualification : First welder as per IS-7307(Part-I) First welder at all test then other welder As per IS 7310 (Part I) – 1974
10. Welding parameters and technique :
- 10.1 Welding parameter :

Weld Pass		Electrodes/ Wire dia. (mm)	Current Amp.	Arc Voltage (volt)	Wire feed Speed (m/min)	Travel Speed (m/min)	Electrode Stick out (mm)	Gas flow (l/min)
Front side	Back Side							
	single	1.2MM	180-220	22-26	controlled by current	N.A.	12-15	15-20

- 10.2 Welding sequence :

11. Provision of running & run off tabs : N.A.
12. Cleaning of weld bead before laying next weld bead : N.A.
13. Root preparation before welding other side of groove weld : N.A.
14. Preheating & interpass temperature : Min-75°C , Interpass Max- 250°C
15. Peening : N.A
16. Post weld treatment : N.A.
17. Rectification of weld defects : By grinding of the defective weld & rectifying the weld as per Cl 32.2 of IS 9595-96, using A3 class of electrodes of specn IRS M.28-12 after conducting D P test.
18. Inspection of weld : Visually, D.P.Test & Macro Etching

11-06-21
 Assistant Research Officer (Met)
 Research Officer (Met)
 11-06-21

7/93


91.4M OWG (25T LOADING)

Name and Address of Fabricator

: M/s M.G.Contractors Pvt. Ltd.,
Vill- Gola, Kalpi-Naraingarh Road,
Opposite E-max Education City,
Mullana, Ambala (HR) 133104
MGCPL/20-21/DFCCIL/SSM-RFO/91.4M/SAW/WPSS-040

Welding procedure specification No.

- 1 Drawing No. : RDSO/B-17184/12
PAD PLATE OF END CROSS GIRDER
- 2 Weld joint description : WEB (16MM) +FLANGE (16MM) WELDING -8MM
- 3 Base metal : IS:2062 : 2011 E 350 Quality -B0
- 4 Welding process : GMAW
- 5 Welding position : Horizontal-Vertical
- 6 Welding consumables :
6.1 Electrode/wire – Electrode : Class: Class-I of IRS M.46
Type: Copper coated solid wire
Dia: 1.2 mm (copper coated)
Drying Method: N.A.
- 6.2 Flux : Class: N.A.
Type: : N.A.
Drying Method: N.A.
- 6.3 Shielding gas : CO2
- 7.0 Base metal preparation : Fusion faces and adjacent surfaces are cleaned and made free from cracks, notches, mill scale, grease, paint, rust etc., which might affect weld quality.
- 7.1 Joint design details : Sketch showing arrangements of parts, weld groove details, weld passes & their sequence etc.

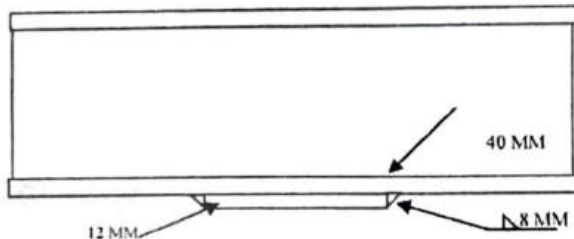

11.06.21
Dr. Chandra Prakash
Dr. Chandra Prakash अधिकारी (प्रा.प्र.)
Assistant Research Officer (Met)
रिसर्च ऑफिसर (मेटल) - 11

- 7.2 Joint preparation : As per IS 10178, Cl. 7, IRS B1 – 2001, Cl. 17.3, & WBC - 2001
- 8 Welding current : Type: DC
Polarity: Reverse
- 9 Welder qualification : First welder as per IS-7307(Part-I) First welder at all test then other welder As per IS 7310 (Part I) – 1974
- 10 Welding parameters and technique
- 10.1 Welding parameter



Dr. Chandra Prakash
Dr. Chandra Prakash अधिकारी (प्रा.प्र.)
Assistant Research Officer (Met)
रिसर्च ऑफिसर (मेटल) - 11

7/94

91.4M OWG (25T LOADING)

Weld Pass		Electrodes/ Wire dia. (mm)	Current Amp.	Arc Voltage (volt)	Wire feed Speed (m/min)	Travel Speed (m/min)	Electrode Stick out (mm)	Gas flow (l/min)
Front side	Back Side							
	single	1.2MM	180-220	22-26	controlled by current	N.A.	12-15	15-20

10.2 Welding sequence :

11. Provision of running & run off tabs : N.A.
12. Cleaning of weld bead before laying next weld bead : N.A.
13. Root preparation before welding other side of groove weld : N.A.
14. Preheating & Interpass temperature : Min-75°C , Interpass Max- 250°C
15. Peening : N.A
16. Post weld treatment : N.A.
17. Rectification of weld defects : By grinding of the defective weld & rectifying the weld as per Cl 32.2 of IS 9595-96, using A3 class of electrodes of specn IRS M.28-12 after conducting D P test.
18. Inspection of weld : Visually, D.P.Test & Macro Etching

7/95

91.4M OWG (25T LOADING)

Name and Address of Fabricator

: M/s M.G Contractors Pvt. Ltd.,
Vill- Gola, Kalpi-Naraingarh Road,
Opposite E-max Education City,
Mullana, Ambala (HR) 133104
MGCPL/20-21/DFCCIL/SSM-RFO/91.4M/SAW/WPSS-041

Welding procedure specification No.

1. Drawing No.

: RDSO/B-17184/13/1
END STRINGER BRACKET

2. Weld joint description

: WEB (16MM) + FLANGE (16MM)

3. Base metal

: IS:2062 : 2011 E 350 Quality -B0

4. Welding process

: GMAW

5. Welding position

: Horizontal-Vertical

6. Welding consumables

6.1 Electrode/wire - Electrode

: Class: Class-I of IRS M.46
Type: Copper coated solid wire
Dia: 1.2 mm (copper coated)
Drying Method: N.A

6.2 Flux

: Class: N.A.
Type: : N.A.
Drying Method: N.A.

6.3 Shielding gas


: CO2

7.0 Base metal preparation

: Fusion faces and adjacent surfaces are cleaned and made
free from cracks, notches, mill scale, grease, paint, rust etc.,
which might affect weld quality.

7.1 Joint design details

: Sketch showing arrangements of parts, weld groove details,
weld passes & their sequence etc.

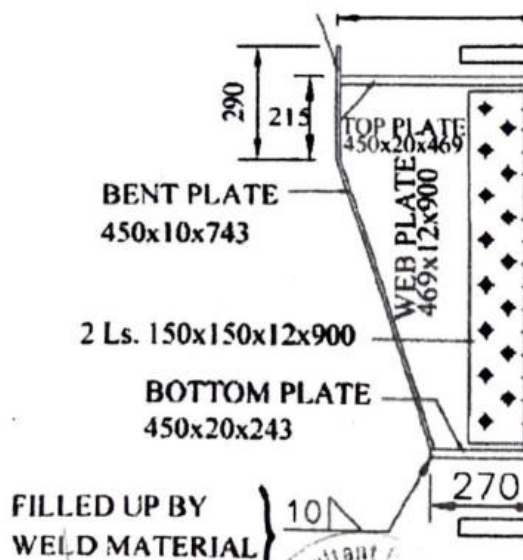

11.06.21

विकास बसु
Assistant Research Officer (Met)
रेल मंत्रालय बल्लभ-11

7/96

91.4M OWG (25T LOADING)

- 7.2 Joint preparation : As per IS 10178, Cl. 7, IRS B1 – 2001, Cl. 17.3, & WBC - 2001
8. Welding current : Type : DC
Polarity: Reverse
9. Welder qualification : First welder as per IS-7307(Part-I) First welder at all test the other welder As per IS 7310 (Part I) – 1974
10. Welding parameters and technique :
- 10.1 Welding parameter :

Weld Pass		Electrodes/ Wire dia. (mm)	Current Amp.	Arc Voltage (volt)	Wire feed Speed (m/min)	Travel Speed (m/min)	Electrode Stick out (mm)	Gas flow (l/min)
Front side	Back Side							
	single +	1.2MM	180-220	22-26	controlled by current	N.A.	12-15	15-20

- 10.2 Welding sequence :

11. Provision of running & run off tabs : N.A.
12. Cleaning of weld bead before laying next weld bead : **YES**
13. Root preparation before welding other side of groove weld : N.A.
14. Preheating & interpass temperature : Min-75°C , Interpass Max- 250°C
15. Peening : N.A.
16. Post weld treatment : N.A.
17. Rectification of weld defects : By grinding of the defective weld & rectifying the weld as per Cl 32.2 of IS 9595-96, using A3 class of electrodes of specn IRS M.28-12 after conducting D P test.
18. Inspection of weld : Visually, D.P.Test & Macro Etching

[Signature]
11.06.21
असिस्टन्ट अनुसंधान अधिकारी (असिस्टन्ट)
Assistant Research Officer (Met)
असिस्टन्ट अनुसंधान अधिकारी (असिस्टन्ट)
Assistant Research Officer (Met)

7/97

91.4M OWG (25T LOADING)


Name and Address of Fabricator

M/s M.G Contractors Pvt. Ltd.,
Vill- Gola, Kalpi-Naraingarh Road,
Opposite E-max Education City,
Mullana, Ambala (HR) 133104

Welding procedure specification No.

MGCPL/20-21/DFCCIL/SSM-RFO/91.4M/SAW/WPSS-042

- | | | | |
|-----|----------------------------|---|---|
| 1. | Drawing No. | : | RDSO/B-17184/13/2
Stiffening plate with Stringer Web |
| 2. | Weld joint description | : | WEB (12MM) +SF PLATE (10MM) WELDING -8MM |
| 3. | Base metal | : | IS:2062 : 2011 E 350 Quality -B0 |
| 4. | Welding process | : | GMAW |
| 5. | Welding position | : | Horizontal-Vertical |
| 6. | Welding consumables | : | |
| 6.1 | Electrode/wire – Electrode | : | Class: Class-I of IRS M.46
Type: Copper coated solid wire
Dia: 1.2 mm (copper coated)
Drying Method: N.A. |
| 6.2 | Flux | : | Class: N.A.
Type: N.A.
Drying Method: N.A. |
| 6.3 | Shielding gas | : | CO2 |
| 7.0 | Base metal preparation | : | Fusion faces and adjacent surfaces are cleaned and made free from cracks, notches, mill scale, grease, paint, rust etc., which might affect weld quality. |
| 7.1 | Joint design details | : | Sketch showing arrangements of parts, weld groove details, weld passes & their sequence etc. |

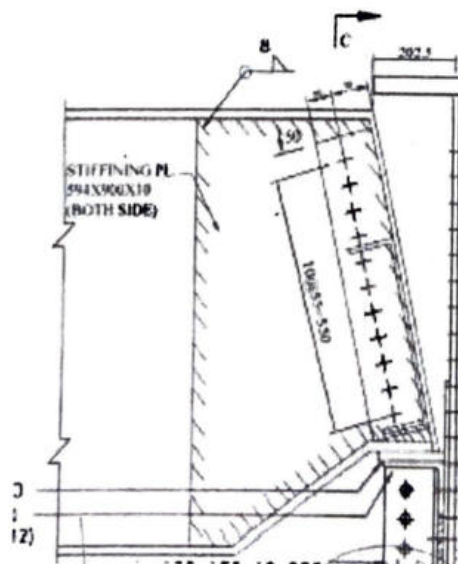

11.06.21
वहावक अनुसंधान विभाग (आर) (मो)
Assistant Research Officer (Mo)
भारतीय रेल बंगलुरु बंगलुरु-11

रूप मुख परियोजना प्रबंधक
Chief Project Manager
भारतीय रेल बंगलुरु बंगलुरु-11

7/98

91.4M OWG (25T LOADING)

- 7.2 Joint preparation : As per IS 10178, Cl. 7, IRS B1 – 2001, Cl. 17.3, & WBC - 2001
8. Welding current : Type : DC
Polarity: Reverse
9. Welder qualification : First welder as per IS-7307(Part-I) First welder at all test the other welder As per IS 7310 (Part I) – 1974
10. Welding parameters and technique :
- 10.1 Welding parameter :

Weld Pass		Electrodes/ Wire dia. (mm)	Current Amp.	Arc Voltage (volt)	Wire feed Speed (m/min)	Travel Speed (m/min)	Electrode Stick out (mm)	Gas flow (l/min)
Front side	Back Side							
	single	1.2MM	180-220	22-26	controlled by current	N.A.	12-15	15-20

- 10.2 Welding sequence :

11. Provision of running & run off tabs : N.A.
12. Cleaning of weld bead before laying next weld bead : N.A.
13. Root preparation before welding other side of groove weld : N.A.
14. Preheating & interpass temperature : Min-75°C , Interpass Max- 250°C
15. Peening : N.A.
16. Post weld treatment : N.A.
17. Rectification of weld defects : By grinding of the defective weld & rectifying the weld as per Cl 32.2 of IS 9595-96, using A3 class of electrodes of specn IRS M 28 after conducting D P test
18. Inspection of weld : Visually, D.P.Test & Macro Etching

Signature
11.06.21
Assistant Research Officer (Met)
योगेश्वर प्रसाद शर्मा (मेट)

7/99

91.4M OWG (25T LOADING)


Welding Procedure Specification Sheet (WPSS)


Name and Address of Fabricator

: M/s M.G Contractors Pvt. Ltd.,
Vill- Gola, Kalpi-Naraingarh Road,
Opposite E-max Education City,
Mullana, Ambala (HR) 133104
MGCP/20-21/DFCCIL/SSM-RFO/91.4M/MMAW/WPSS-43

Welding procedure specification No.

- | | | | |
|------|--|---|---|
| 1. | Drawing No. | : | All relevant drawings. |
| 2. | Weld joint description | : | 5 mm Tack welds on all joints. |
| 3. | Base metal | : | IS:2062 : 2006 E 350 Quality-B0 |
| 4. | Welding process | : | MMAW |
| 5. | Welding position | : | Horizontal-Vertical |
| 6. | Welding consumables | : | Class: B1/B2 class of electrodes of IRS M.28 |
| 6.1 | Electrode/wire – Electrode | : | Type: Medium coated
Dia: 3.15 mm
Drying Method: As recommended by the electrode manufacturer. |
| 6.2 | Flux | : | Class: N.A
Type: N.A
Drying Method: N.A |
| 6.3 | Shielding gas | : | N.A |
| 7.0 | Base metal preparation | : | Fusion faces and adjacent surfaces are cleaned and made free from cracks, notches, mill scale, grease, paint, rust etc., which might affect weld quality. |
| 7.1 | Joint design details
(Sketch showing arrangements of parts, weld groove details, weld passes & their sequence etc.) | : | Length of Tack weld 50 mm, Gap between two Tack welds 300 mm. |
| 7.2 | Joint preparation | : | As per IS 9595, Cl. 7, IRS B1 – 2001, Cl. 17.3, & WBC - 2001 |
| 8. | Welding current | : | Type : DC
Polarity: Reverse |
| 9. | Welder qualification | : | First welder as per IS-7303(part-I) First welder at all post then other welder As per IS 7310 (Part I) – 1974 |
| 10. | Welding parameters and technique | : | |
| 10.1 | Welding parameter | : | |

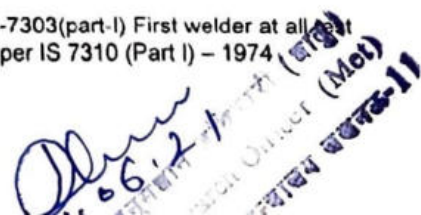
 M.G Contractors Pvt. Ltd.
 Ambala (HR) 133104

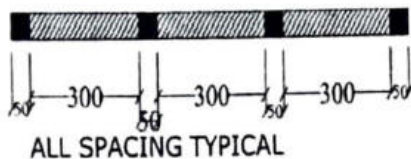91.4M OWG (25T LOADING)**10.2 Welding sequence**

Weld Pass	Electrodes/ Wire dia. (mm)	Current Amp.	Arc Voltage (volt)	Wire feed Speed (m/min)	Travel Speed (m/min)	Electrode Stick out (mm)	Gas flow (l/min)
1st.	4	120-160	20-26	N.A	N.A	N.A	N.A


- | | | | |
|-----|---|---|--|
| 11. | Provision of running & run off tabs | : | N.A. |
| 12. | Cleaning of weld bead before laying next weld bead | : | N.A. |
| 13. | Root preparation before welding other side of groove weld | : | N.A. |
| 14. | Preheating & interpass temperature | : | N.A. |
| 15. | Peening | : | N.A. |
| 16. | Post weld treatment | : | N.A. |
| 17. | Rectification of weld defects | : | By grinding of the defective weld & rectifying the weld as per C I - 32.2 of IS 9595-96, using A3 class of electrodes of specn IRS M.28 after conducting D P test. |
| 18. | Inspection of weld | : | Visually |

11.06.21
 Assistant Research Officer (Met)
 11.06.21


Railway Open Web Girder (25t loading)
106.7m clear span

MODEL WPSS No- RDSO/ Infra-II/ B&S/ RG/
OWG./ WPSS 106.7 series (30 nos)

Welding Procedure Specification Sheet for 106.7 m. Span Open Web Girder (Welded through type) 25 T Loading – 2008

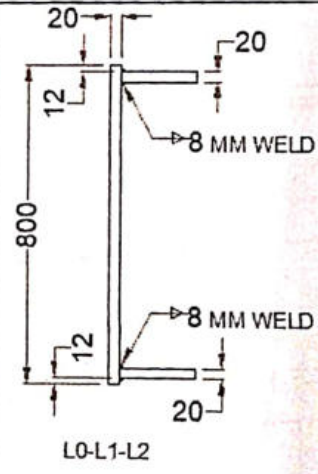Name and address of Fabricator		:	M/s. Royal Infraconstru Ltd., Urla Industrial Growth Centre, Raipur – 493221 (C.G.)
Welding Procedure specification No.		:	ROYAL/STVOK-RANGPO/106.7/01 dated 5/8/2022
01.	Drawing No.	:	RDSO/B-17185/R (G.A.)
02.	Welding Joint Description.	:	Fillet 8 mm
03.	Base Metal.	:	IS: 2062:2011 E-350 C.
04.	Welding Process	:	S.A.W.
05.	Welding Position.	:	Flat
06.	Welding Consumable.	:	
6.1	Electrode/Wire	Class :	W2 of IRS M.39-2001.
		Type :	Copper coated Solid Wire.
		Drying Method :	N.A.
6.2	Flux		
		Class :	F2 of IRS M.39 – 2001
		Type :	Agglomerated.
		Drying Method :	Recommendation as per manufacturer.
6.3	Shielding Gas	:	N.A.
07.	Base Metal Preparation	:	Fusion Faces and adjacent surfaces are cleaned and made free from Cracks, Notches, Mill scale, Grease, Paint, Rust etc., which may affected weld quality.
7.1	Joint design Details	:	
	(Sketch showing arrangements of parts, weld beat, weld passes & their sequence etc.) 1. Bottom Chord L0-L1-L2		 <p>20 12 800 12 20 8 MM WELD 8 MM WELD 20 L0-L1-L2</p> <p>सहायक अनुसंधान अधिकारी (संग) Assistant Research Officer (M) राजस्थान राज्य सरकार</p>
7.2	Joint preparation	:	As Per IS: 4353 – 1995, CI.7, IRS B1-2001, CI.17.3 & WBC – 2001.
08.	Welding Current	:	
		Type :	DC
		Polarity :	Reverse
09.	Welder qualification	:	As per IS: 7310/7307 (Part-I) – 1974
10.	Welding Parameters and technique	:	
10.1	Welding Parameters	:	


Weld Sequence No.	Electrodes wire dia. (mm)	Current (Amps)	Arc Voltage (Volt)	Wire Feed Speed (m/min)	Travel Speed (m/min)	Electrical Stick out (mm)	Gas Flow (l/min.)
1	4	550 – 600	28 – 32	1.4 – 1.8	0.35 – 0.50	15 – 20	N.A.

10.2	Welding Sequence and technique	:	Welding from run on to run off tabs at the free ends.
			

11.	Provision of run-on / run-off tabs	:	Yes
12.	Cleaning of weld bead before laying next weld bead	:	By brush cleaning & grinding
13.	Root preparation before welding other side of groove weld	:	N.A.
14.	Preheating and inter pass temperature	:	N.A. 110-150°C
15.	Peening	:	N.A.
16.	Post Weld treatment	:	N.A.
17.	Rectification of weld defect	:	By re-welding after complete removal of defective weld & rectify the weld as per CI.32.2 of IS 9595-96, using B1 class of Electrodes of spec. IRS M.28-2017 after conducting DP Test.
18.	Inspection of Weld	:	Visual, D.P. Test & Macro Etching.
19.	Any other relevant Details	:	Bottom Chord L0 –L1 & L1 – L2, Diagonal U1–L2 & End Raker L0-U1.

205


Welding Procedure Specification Sheet for 106.7 m. Span Open Web Girder (Welded through type) 25 T Loading – 2008

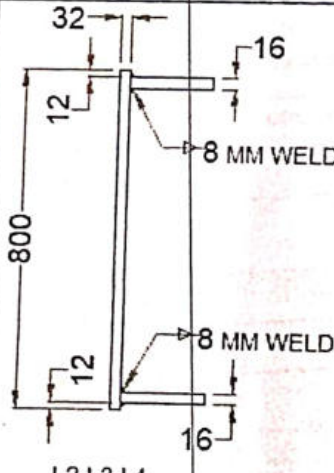Name and address of Fabricator		:	M/s. Royal Infraconstru Ltd., Urli Industrial Growth Centre, Raipur – 493221 (C.G.)
Welding Procedure specification No.		:	ROYAL /SIVOK-RANGPO/106.7/02 dated 5/8/2022
01.	Drawing No.	:	RDSO/B-17185/R (G.A.)
02.	Welding Joint Description.	:	Fillet 8 mm
03.	Base Metal.	:	IS: 2062:2011 E-350 C.
04.	Welding Process	:	S.A.W.
05.	Welding Position.	:	Flat
06.	Welding Consumable.	:	
6.1	Electrode/Wire	Class :	W2 of IRS M.39-2001.
		Type :	Copper coated Solid Wire.
		Drying Method :	N.A.
6.2	Flux		
		Class :	F2 of IRS M.39 – 2001
		Type :	Agglomerated.
		Drying Method :	Recommendation as per manufacturer.
6.3	Shielding Gas	:	N.A.
07.	Base Metal Preparation	:	Fusion Faces and adjacent surfaces are cleaned and made free from Cracks, Notches, Mill scale, Grease, Paint, Rust etc., which may affected weld quality.
7.1	Joint design Details	:	
	(Sketch showing arrangements of parts, weld beat, weld passes & their sequence etc.,) Component :- Bottom Chord L2 - L3 - L4 Flange with Web		
7.2	Joint preparation	:	As Per IS: 4353 – 1995, CI.7, IRS B1-2001, CI.17.3 & WBC – 2001.
08.	Welding Current	:	
	Type	:	DC
	Polarity	:	Reverse
09.	Welder qualification	:	As per IS: 7310/7307 (Part-I) – 1974
10.	Welding Parameters and technique	:	
10.1	Welding Parameters	:	

Prasenjit Purkavastha


ROYAL -ITL (JV)

Weld Sequence No.	Electrodes wire dia. (mm)	Current (Amps)	Arc Voltage (Volt)	Wire Feed Speed (m/min)	Travel Speed (m/min)	Electrical Stick out (mm)	Gas Flow (l/min.)
1	4	530 - 570	28 - 32	1.4 - 1.8	0.35 - 0.50	15 - 20	N.A.

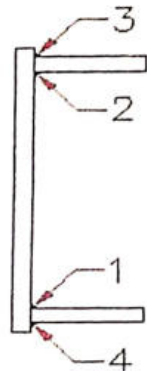10.2	Welding Sequence and technique	:	Welding from run on to run off tabs at the free ends.
			

11.	Provision of run-on / run-off tabs	:	Yes
12.	Cleaning of weld bead before laying next weld bead	:	By brush cleaning & grinding
13.	Root preparation before welding other side of groove weld	:	N.A.
14.	Preheating and inter pass temperature	:	N.A. 210-150°C
15.	Peening	:	N.A.
16.	Post Weld treatment	:	N.A.
17.	Rectification of weld defect	:	By re-welding after complete removal of defective weld & rectify the weld as per CI.32.2 of IS 9595-96, using B1 class of Electrodes of specn. IRS M.28-2017 after conducting DP Test.
18.	Inspection of Weld	:	Visual, D.P. Test & Macro Etching.
19.	Any other relevant Details	:	Bottom Chord L2 - L3 - L4


Welding Procedure Specification Sheet for 106.7 m. Span Open Web Girder (Welded through type) 25 T Loading – 2008

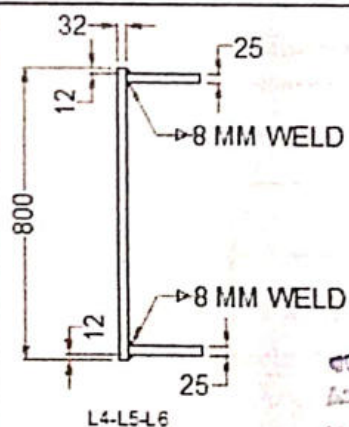Name and address of Fabricator		:	M/s. Royal Infraconstru Ltd., Uria Industrial Growth Centre, Raipur – 493221 (C.G.)
Welding Procedure specification No.		:	ROYAL /SIVOK-RANGPO/106.7/03 dated 5/8/2022
01.	Drawing No.	:	RDSO/B-17185/R (G.A.)
02.	Welding Joint Description.	:	Fillet 8 mm
03.	Base Metal.	:	IS: 2062:2011 E-350 C.
04.	Welding Process	:	S.A.W.
05.	Welding Position.	:	Flat
06.	Welding Consumable.	:	
6.1	Electrode/Wire		
	Class	:	W2 of IRS M.39-2001.
	Type	:	Copper coated Solid Wire.
6.2	Flux		
	Drying Method	:	N.A.
	Class	:	F2 of IRS M.39 – 2001
	Type	:	Agglomerated.
6.3	Shielding Gas		
	Drying Method	:	Recommendation as per manufacturer.
07.	Base Metal Preparation	:	Fusion Faces and adjacent surfaces are cleaned and made free from Cracks, Notches, Mill scale, Grease, Paint, Rust etc., which may affected weld quality.
7.1	Joint design Details	:	
	(Sketch showing arrangements of parts, weld beat, weld passes & their sequence etc.,) Component :- Bottom Chord L4 –L5-L6 Flange with Web		
7.2	Joint preparation	:	As Per IS: 4353 – 1995, CI.7, IRS B1-2001, CI.17.3 & WBC – 2001.
08.	Welding Current	:	
	Type	:	DC
	Polarity	:	Reverse
09.	Welder qualification	:	As per IS: 7310/7307 (Part-I) – 1974
10.	Welding Parameters and technique	:	
10.1	Welding Parameters	:	

Prasenjit Purkayastha

ROYAL -ITL (JV)


Weld Sequence No.	Electrodes wire dia. (mm)	Current (Amps)	Arc Voltage (Volt)	Wire Feed Speed (m/min)	Travel Speed (m/min)	Electrical Stick out (mm)	Gas Flow (l/min.)
1	4	530 - 570	28 - 32	1.4 - 1.8	0.35 - 0.50	15 - 20	N.A.

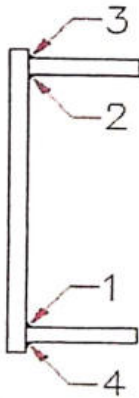10.2	Welding Sequence and technique	:	Welding from run on to run off tabs at the free ends.
			

11.	Provision of run-on / run-off tabs	:	Yes
12.	Cleaning of weld bead before laying next weld bead	:	By brush cleaning & grinding
13.	Root preparation before welding other side of groove weld	:	N.A.
14.	Preheating and inter pass temperature	:	N.A. (110° - 150°C)
15.	Peening	:	N.A.
16.	Post Weld treatment	:	N.A.
17.	Rectification of weld defect	:	By re-welding after complete removal of defective weld & rectify the weld as per CI.32.2 of IS 9595-96, using B1 class of Electrodes of specn. IRS M.28-2017 after conducting DP Test.
18.	Inspection of Weld	:	Visual, D.P. Test & Macro Etching.
19.	Any other relevant Details	:	Bottom Chord L4 - L5-L6

207


Welding Procedure Specification Sheet for 106.7 m. Span Open Web Girder (Welded through type) 25 T Loading – 2008

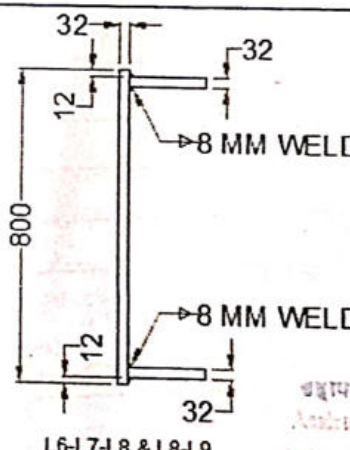Name and address of Fabricator		:	M/s. Royal Infraconstru Ltd., Urli Industrial Growth Centre, Raipur – 493221 (C.G.)
Welding Procedure specification No.		:	ROYAL/SIVOK-RANGPO/106.7/04 dated 5/8/2022
01.	Drawing No.	:	RDSO/B-17185/R (G.A.)
02.	Welding Joint Description.	:	Fillet 8mm
03.	Base Metal.	:	IS: 2062:2011 E-350 C.
04.	Welding Process	:	S.A.W.
05.	Welding Position.	:	Flat
06.	Welding Consumable.	:	
6.1	Electrode/Wire		
	Class	:	W2 of IRS M.39-2001.
	Type	:	Copper coated Solid Wire.
6.2	Flux	Drying Method	: N.A.
6.3		Class	: F2 of IRS M.39 – 2001
		Type	: Agglomerated.
		Drying Method	: Recommendation as per manufacturer.
07.	Base Metal Preparation	:	N.A.
7.1	Joint design Details	:	
	(Sketch showing arrangements of parts, weld beat, weld passes & their sequence etc.,) Component: - Bottom Chord L6-L7-L8 & L8-L9 Flange with Web		 <p>800</p> <p>32</p> <p>12</p> <p>8 MM WELD</p> <p>8 MM WELD</p> <p>32</p> <p>L6-L7-L8 & L8-L9</p> <p>Signature: [Handwritten Signature]</p> <p>Project Research Officer (M)</p>
7.2	Joint preparation	:	As Per IS: 4353 – 1995, CI.7, IRS B1-2001, CI.17.3 & WBC – 2001.
08.	Welding Current	:	
	Type	:	DC
	Polarity	:	Reverse
09.	Welder qualification	:	As per IS: 7310/7307 (Part-I) – 1974
10.	Welding Parameters and technique	:	
10.1	Welding Parameters		

Prasenjit Purkayastha
General Manager / PH Sivok II

ROYAL - I/TL (JV)


Weld Sequence No.	Electrodes wire dia. (mm)	Current (Amps)	Arc Voltage (Volt)	Wire Feed Speed (m/min)	Travel Speed (m/min)	Electrical Stick out (mm)	Gas Flow (l/min.)
1	4	530 - 560	28 - 30	1.4 - 1.8	0.35 - 0.50	15 - 20	N.A.

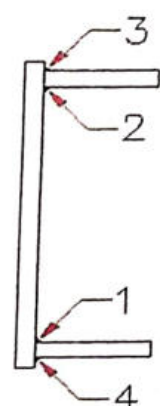10.2	Welding Sequence and technique	:	Welding from run on to run off tabs at the free ends.
			


11.	Provision of run-on / run-off tabs	:	Yes
12.	Cleaning of weld bead before laying next weld bead	:	By brush cleaning & grinding
13.	Root preparation before welding other side of groove weld	:	N.A.
14.	Preheating and inter pass temperature	:	N.A. (110°C - 150°C)
15.	Peening	:	N.A.
16.	Post Weld treatment	:	N.A.
17.	Rectification of weld defect	:	By re-welding after complete removal of defective weld & rectify the weld as per CI.32.2 of IS 9595-96, using B1 class of Electrodes of specn. IRS M.28-2017 after conducting DP Test.
18.	Inspection of Weld	:	Visual, D.P. Test & Macro Etching.
19.	Any other relevant Details	:	Bottom Chord L6-L7-L8 & L8-L9

Appendix-V (Ref.C726 of B I-2001).

Welding Procedure Specification Sheet for 106.7 m. Span Open Web Girder (Welded through type) 25 T Loading – 2008

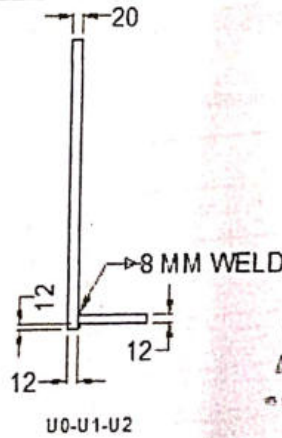
Name and address of Fabricator		:	M/s. Royal Infraconstru Ltd., Urli Industrial Growth Centre, Raipur – 493221 (C.G.)
Welding Procedure specification No.		:	ROYAL/SIVOK-RANGPO/106.7/05 dated 5/8/2022
01.	Drawing No.	:	RDSO/B-17185/R (G.A.)
02.	Welding Joint Description.	:	Fillet 8mm
03.	Base Metal.	:	IS: 2062:2011 E-350 C.
04.	Welding Process	:	S.A.W.
05.	Welding Position.	:	Flat
06.	Welding Consumable.	:	
6.1	Electrode/Wire	Class :	W2 of IRS M.39-2001.
		Type :	Copper coated Solid Wire.
		Drying Method :	N.A.
6.2	Flux	Class :	F2 of IRS M.39 – 2001
		Type :	Agglomerated.
		Drying Method :	Recommendation as per manufacturer.
6.3	Shielding Gas	:	N.A.
07.	Base Metal Preparation	:	Fusion Faces and adjacent surfaces are cleaned and made free from Cracks, Notches, Mill scale, Grease, Paint, Rust etc., which may affected weld quality.
7.1	Joint design Details	:	
	(Sketch showing arrangements of parts, weld beat, weld passes & their sequence etc.,) Component: - Top Chord U0- U1 – U2 Web with Flange		 <p>U0-U1-U2</p> <p>8 MM WELD</p> <p>20</p> <p>12</p> <p>12</p> <p>12</p> <p>Signature of Assistant Research Officer (M)</p> <p>बिहार अनुसंधान अधिकारी (विश्व)</p> <p>Assistant Research Officer (M)</p> <p>राजस्थान केन्द्र, रायपुर</p>
7.2	Joint preparation	:	As Per IS: 4353 – 1995, CI.7, IRS B1-2001, CI.17.3 & WBC – 2001.
08.	Welding Current	:	
		Type :	DC
		Polarity :	Reverse
09.	Welder qualification	:	As per IS: 7310/7307 (Part-I) – 1974
10.	Welding Parameters and technique	:	
10.1	Welding Parameters	Prasenjit Purkayastha ; General Manager / PH-Sivok-II	ROYAL-ITL (JV)

Weld Sequence No.	Electrodes wire dia. (mm)	Current (Amps)	Arc Voltage (Volt)	Wire Feed Speed (m/min)	Travel Speed (m/min)	Electrical Stick out (mm)	Gas Flow (l/min.)
1	4	530 – 560	28 – 30	1.4 – 1.8	0.35 – 0.50	15 – 20	N.A.

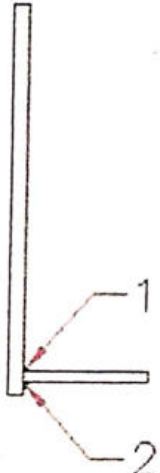10.2	Welding Sequence and technique	:	Welding from run on to run off tabs at the free ends.
			

11.	Provision of run-on / run-off tabs	:	Yes
12.	Cleaning of weld bead before laying next weld bead	:	By brush cleaning & grinding
13.	Root preparation before welding other side of groove weld	:	N.A.
14.	Preheating and inter pass temperature	:	N.A. (110°C - 150°C)
15.	Peening	:	N.A.
16.	Post Weld treatment	:	N.A.
17.	Rectification of weld defect	:	By re-welding after complete removal of defective weld & rectify the weld as per CI.32.2 of IS 9595-96, using B1 class of Electrodes of specn. IRS M.28-2017 after conducting DP Test
18.	Inspection of Weld	:	Visual, D.P. Test & Macro Etching.
19.	Any other relevant Details	:	Top Chord Top Chord U0- U1 – U2

Welding Procedure Specification Sheet for 106.7 m. Span Open Web Girder (Welded through type) 25 T Loading – 2008

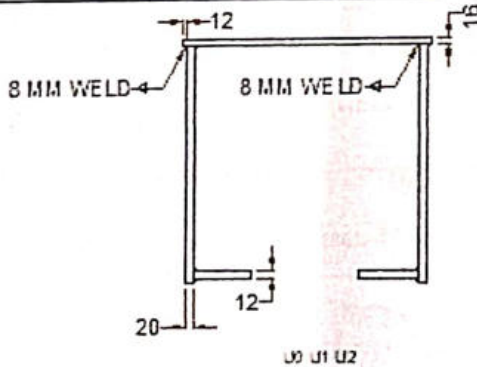
Name and address of Fabricator	:	M/s. Royal Infraconstru Ltd., Uda Industrial Growth Centre, Raipur – 493221 (C.G.)
Welding Procedure specification No.	:	ROYAL/SIVOK-RANGPO/106.7/06 dated 5/8/2022
01. Drawing No.	:	RDSO/B-17185/R (G.A.)
02. Welding Joint Description.	:	Fillet 8 mm
03. Base Metal.	:	IS: 2062:2011 E-350 C.
04. Welding Process	:	S.A.W.
05. Welding Position.	:	Flat
06. Welding Consumable.	:	
6.1	Electrode/Wire	
	Class	: W2 of IRS M.39-2001.
	Type	: Copper coated Solid Wire.
	Drying Method	: N.A.
6.2	Flux	
	Class	: F2 of IRS M.39 – 2001
	Type	: Agglomerated.
	Drying Method	: Recommendation as per manufacturer.
6.3	Shielding Gas	: N.A.
07.	Base Metal Preparation	: Fusion Faces and adjacent surfaces are cleaned and made free from Cracks, Notches, Mill scale, Grease, Paint, Rust etc., which may affected weld quality.
7.1	Joint design Details	:
	(Sketch showing arrangements of parts, weld beat, weld passes & their sequence etc.,) Component :- Top Chord U0 – U1- U2 Web with Top flange	
7.2	Joint preparation	: As Per IS:4353 – 1995, CI.7, IRS B1-2001, CI.17.3 & WBC – 2001.
08.	Welding Current	:
	Type	: DC
	Polarity	: Reverse
09.	Welder qualification	: As per IS: 7310/7307 (Part-I) – 1974
10.	Welding Parameters and technique	:
10.1	Welding Parameters	:

Weld Sequence No.	Electrodes wire dia. (mm)	Current (Amps)	Arc Voltage (Volt)	Wire Feed Speed (m/min)	Travel Speed (m/min)	Electrical Stick out (mm)	Gas Flow (l/min.)
1	4	540 - 570	28 - 32	1.4 - 1.8	0.35 - 0.50	15 - 20	N.A.


10.2	Welding Sequence and technique	:	Welding from run on to run off tabs at the free ends.

11.	Provision of run-on / run-off tabs	:	Yes
12.	Cleaning of weld bead before laying next weld bead	:	By brush cleaning & grinding
13.	Root preparation before welding other side of groove weld	:	N.A.
14.	Preheating and inter pass temperature	:	N.A. (110°C - 150°C)
15.	Peening	:	N.A.
16.	Post Weld treatment	:	N.A.
17.	Rectification of weld defect	:	By re-welding after complete removal of defective weld & rectify the weld as per CI.32.2 of IS 9595-96, using B1 class of Electrodes of specn. IRS M.28-2017 after conducting DP Test.
18.	Inspection of Weld	:	Visual, D.P. Test & Macro Etching.
19.	Any other relevant Details	:	Top Chord U0 - U1- U2

Welding Procedure Specification Sheet for 106.7 m. Span Open Web Girder (Welded through type) 25 T Loading – 2008

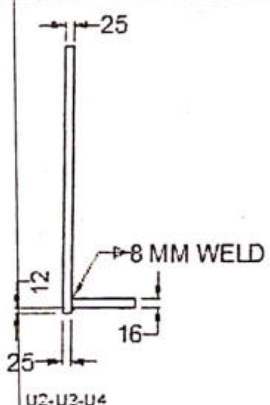Name and address of Fabricator		:	M/s. Royal Infraconstru Ltd., Urbi Industrial Growth Centre, Raipur – 493221 (C.G.)
Welding Procedure specification No.		:	ROYAL/SIVOK-RANGPO/106.7/07 dated 5/8/2022
01.	Drawing No.	:	RDSO/B-17185/R (G.A.)
02.	Welding Joint Description.	:	Fillet 8 mm
03.	Base Metal.	:	IS: 2062:2011 E-350 C.
04.	Welding Process	:	S.A.W.
05.	Welding Position.	:	Flat
06.	Welding Consumable.	:	
6.1	Electrode/Wire	Class :	W2 of IRS M.39-2001.
		Type :	Copper coated Solid Wire.
		Drying Method :	N.A.
6.2	Flux	:	
		Class :	F2 of IRS M.39 – 2001
		Type :	Agglomerated.
		Drying Method :	Recommendation as per manufacturer.
6.3	Shielding Gas	:	N.A.
07.	Base Metal Preparation	:	Fusion Faces and adjacent surfaces are cleaned and made free from Cracks, Notches, Mill scale, Grease, Paint, Rust etc., which may affected weld quality.
7.1	Joint design Details	:	
	(Sketch showing arrangements of parts, weld beat weld passes & their sequence etc.,) Component :- Top Chord U2- U3 – U4 Web with Flange		 <p>25 12 16 25 8 MM WELD U2-U3-U4</p> <p>सहायक अनुसंधान अधिकारी (सा) Assistant Research Officer (M) राज्य-संशोधन-संस्थान, रायपुर</p>
7.2	Joint preparation	:	As Per IS:4353 – 1995, CI.7, IRS B1-2001, CI.17.3 & WBC – 2001.
08.	Welding Current	:	
	Type	:	DC
	Polarity	:	Reverse
09.	Welder qualification	:	As per IS: 7310/7307 (Part-I) – 1974
10.	Welding Parameters and technique	:	1
10.1	Welding Parameters	:	

Weld Sequence No.	Electrodes wire dia. (mm)	Current (Amps)	Arc Voltage (Volt)	Wire Feed Speed (m/min)	Travel Speed (m/min)	Electrical Stick out (mm)	Gas Flow (l/min.)
1	4	530 - 570	28 - 32	1.4 - 1.8	0.35 - 0.50	15 - 20	N.A.


10.2	Welding Sequence and technique	:	Welding from run on to run off tabs at the free ends.
			

11.	Provision of run-on / run-off tabs	:	Yes
12.	Cleaning of weld bead before laying next weld bead	:	By brush cleaning & grinding
13.	Root preparation before welding other side of groove weld	:	N.A.
14.	Preheating and inter pass temperature	:	N.A. 110°C - 150°C
15.	Peening	:	N.A.
16.	Post Weld treatment	:	N.A.
17.	Rectification of weld defect	:	By re-welding after complete removal of defective weld & rectify the weld as per CI.32.2 of IS 9595-96, using B1 class of Electrodes of specn. IRS M.28-2017 after conducting DP Test.
18.	Inspection of Weld	:	Visual, D.P. Test & Macro Etching.
19.	Any other relevant Details	:	Top Chord U2- U3 - U4

Welding Procedure Specification Sheet for 106.7 m. Span Open Web Girder (Welded through type) 25 T Loading – 2008

Name and address of Fabricator		:	M/s. Royal Infraconstru Ltd., Urli Industrial Growth Centre, Raipur – 493221 (C.G.)
Welding Procedure specification No.		:	ROYAL/SIVOK-RANGPO/106.7/08 dated 5/8/2022
01.	Drawing No.	:	RDSO/B-17185/R (G.A.)
02.	Welding Joint Description.	:	Fillet 8 mm
03.	Base Metal.	:	IS: 2062:2011 E-350 C.
04.	Welding Process	:	S.A.W.
05.	Welding Position.	:	Flat
06.	Welding Consumable.	:	
6.1	Electrode/Wire	Class :	W2 of IRS M.39-2001.
		Type :	Copper coated Solid Wire.
		Drying Method :	N.A.
6.2	Flux	Class :	F2 of IRS M.39 – 2001
		Type :	Agglomerated.
		Drying Method :	Recommendation as per manufacturer.
6.3	Shielding Gas	:	N.A.
07.	Base Metal Preparation	:	Fusion Faces and adjacent surfaces are cleaned and made free from Cracks, Notches, Mill scale, Grease, Paint, Rust etc., which may affected weld quality.
7.1	Joint design Details	:	
	(Sketch showing arrangements of parts, weld beat weld passes & their sequence etc.,) Component :- Top Chord U2 – U3- U4 Web with Top flange		
7.2	Joint preparation	:	As Per IS:4353 – 1995, CI.7, IRS B1-2001, CI.17.3 & WSC – 2001.
08.	Welding Current	:	
		Type :	DC
		Polarity :	Reverse
09.	Welder qualification	:	As per IS: 7310/7307 (Part-I) – 1974
10.	Welding Parameters and technique	:	
10.1	Welding Parameters	:	

Weld Sequence No.	Electrodes wire dia. (mm)	Current (Amps)	Arc Voltage (Volt)	Wire Feed Speed (m/min)	Travel Speed (m/min)	Electrical Stick out (mm)	Gas Flow (l/min.)
1	4	530 – 570	28 – 32	1.4 – 1.8	0.35 – 0.50	15 – 20	N.A.

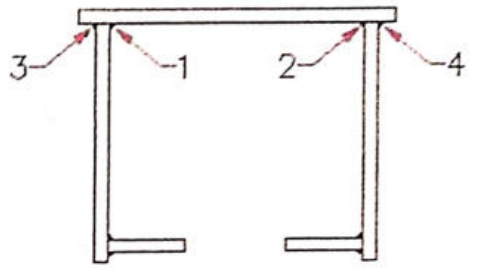10.2	Welding Sequence and technique	:	Welding from run on to run off tabs at the free ends.
			


11.	Provision of run-on / run-off tabs	:	Yes
12.	Cleaning of weld bead before laying next weld bead	:	By brush cleaning & grinding
13.	Root preparation before welding other side of groove weld	:	N.A.
14.	Preheating and inter pass temperature	:	N.A. 110°C - 150°C
15.	Peening	:	N.A.
16.	Post Weld treatment	:	N.A.
17.	Rectification of weld defect	:	By re-welding after complete removal of defective weld & rectify the weld as per CI.32.2 of IS 9595-96, using B1 class of Electrodes of specn. IRS M.28-2017 after conducting DP Test.
18.	Inspection of Weld	:	Visual, D.P. Test & Macro Etching.
19.	Any other relevant Details	:	Top Chord U2 – U3- U4

212

Welding Procedure Specification Sheet for 106.7 m. Span Open Web Girder (Welded through type) 25 T Loading – 2008


Name and address of Fabricator		:	M/s. Royal Infraconstru Ltd., Urla Industrial Growth Centre, Raipur – 493221 (C.G.)
Welding Procedure specification No.		:	ROYAL/SIVOK-RANGPO/106.7/09 dated 5/8/2022
01.	Drawing No.	:	RDSO/B-17185/R (G.A.)
02.	Welding Joint Description.	:	Fillet 8 mm
03.	Base Metal.	:	IS: 2062:2011 E-350 C.
04.	Welding Process	:	S.A.W.
05.	Welding Position.	:	Flat
06.	Welding Consumable.	:	
6.1	Electrode/Wire	Class :	W2 of IRS M.39-2001.
		Type :	Copper coated Solid Wire.
		Drying Method :	N.A.
6.2	Flux	Class :	F2 of IRS M.39 – 2001
		Type :	Agglomerated.
		Drying Method :	Recommendation as per manufacturer.
6.3	Shielding Gas	:	N.A.
07.	Base Metal Preparation	:	Fusion Faces and adjacent surfaces are cleaned and made free from Cracks, Notches, Mill scale, Grease, Paint, Rust etc., which may affected weld quality.
7.1	Joint design Details	:	
	(Sketch showing arrangements of parts, weld beat weld passes & their sequence etc.,) Component :- Top Chord U4 – U5- U6 & U6- U7-U8 & U8-U9 End Raker – M0-U0 & M0-L0 Web with Top flange Web With flange		<p>U4-U5, U6 & U6-U7-U8 & U8-U9 M0-U0 & M0-L0</p> <p>U4-U5, U6 & U6-U7-U8 & U8-U9 M0-U0 & M0-L0</p>
7.2	Joint preparation	:	As Per IS:4353 – 1995, CI.7, IRS B1-2001, CI.17.3 & WBC – 2001.
08.	Welding Current	:	
		Type :	DC
		Polarity :	Reverse
09.	Welder qualification	:	As per IS: 7310/7307 (Part-I) – 1974
10.	Welding Parameters and technique	:	
10.1	Welding Parameters	:	

Weld Sequence No.	Electrodes wire dia. (mm)	Current (Amps)	Arc Voltage (Volt)	Wire Feed Speed (m/min)	Travel Speed (m/min)	Electrical Stick out (mm)	Gas Flow (l/min.)
1	4	530 – 570	28 – 32	1.4 – 1.8	0.35 – 0.50	15 – 20	N.A.

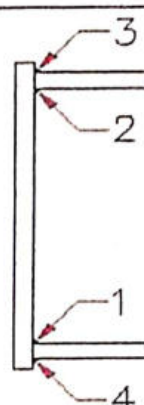
10.2	Welding Sequence and technique	:	Welding from run on to run off tabs at the free ends.
			

11.	Provision of run-on / run-off tabs	:	Yes
12.	Cleaning of weld bead before laying next weld bead	:	By brush cleaning & grinding
13.	Root preparation before welding other side of groove weld	:	N.A.
14.	Preheating and inter pass temperature	:	N.A. 110°C – 150°C
15.	Peening	:	N.A.
16.	Post Weld treatment	:	N.A.
17.	Rectification of weld defect	:	By re-welding after complete removal of defective weld & rectify the weld as per Cl.32.2 of IS 9595-96, using B1 class of Electrodes of specn. IRS M.28-2017 after conducting DP Test.
18.	Inspection of Weld	:	Visual, D.P. Test & Macro Etching.
19.	Any other relevant Details	:	Top Chord & End Raker

Welding Procedure Specification Sheet for 106.7 m. Span Open Web Girder (Welded through type) 25 T Loading - 2008

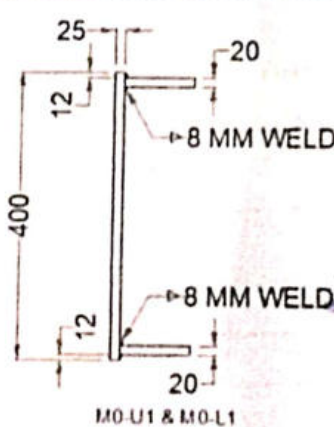
Name and address of Fabricator		:	M/s. Royal Infraconstru Ltd., Urda Industrial Growth Centre, Raipur - 493221 (C.G.)
Welding Procedure specification No.		:	ROYAL/SIVOK/RAHGO/106.7/10 dated 5/8/2022
01.	Drawing No.	:	RD/O/B-17185/R (G.A.)
02.	Welding Joint Description.	:	Fillet 8 mm
03.	Base Metal.	:	IS: 2062:2011 E-350 C.
04.	Welding Process	:	S.A.W.
05.	Welding Position.	:	Flat
06.	Welding Consumable.		
6.1	Electrode/Wire	Class	: W2 of IRS M.39-2001.
		Type	: Copper coated Solid Wire.
		Drying Method	: N.A.
6.2	Flux		
		Class	: F2 of IRS M.39 - 2001
		Type	: Agglomerated.
		Drying Method	: Recommendation as per manufacturer.
6.3	Shielding Gas	:	N.A.
07.	Base Metal Preparation	:	Fusion Faces and adjacent surfaces are cleaned and made free from Cracks, Notches, Mill scale, Grease, Paint, Rust etc., which may affected weld quality.
7.1	Joint design Details	:	
	(Sketch showing arrangements of parts, weld beat weld passes & their sequence etc.,) Component :- Diagonal-M0-U1 & M0-L1 Web With Flange		 <p>M0-U1 & M0-L1</p>
7.2	Joint preparation	:	As Per IS: 4353 - 1995, CI.7, IRS B1-2001, CI.17.3 & WBC - 2001.
08.	Welding Current	:	
	Type	:	DC
	Polarity	:	Reverse
09.	Welder qualification	:	As per IS: 7310/7307 (Part-I) - 1974
10.	Welding Parameters and technique	:	
10.1	Welding Parameters	:	

Weld Sequence No.	Electrodes wire dia. (mm)	Current (Amps)	Arc Voltage (Volt)	Wire Feed Speed (m/min)	Travel Speed (m/min)	Electrical Stick out (mm)	Gas Flow (l/min.)
1	4	530 - 570	28 - 32	1.4 - 1.8	0.35 - 0.50	15 - 20	N.A.

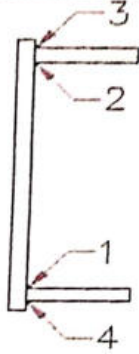10.2	Welding Sequence and technique	:	Welding from run on to run off tabs at the free ends.
			

11.	Provision of run-on / run-off tabs	:	Yes
12.	Cleaning of weld bead before laying next weld bead	:	By brush cleaning & grinding
13.	Root preparation before welding other side of groove weld	:	N.A.
14.	Preheating and inter pass temperature	:	N.A. 110°C - 150°C
15.	Peening	:	N.A.
16.	Post Weld treatment	:	N.A.
17.	Rectification of weld defect	:	By re-welding after complete removal of defective weld & rectify the weld as per CI.32.2 of IS 9595-96, using B1 class of Electrodes of specn. IRS M.28-2017 after conducting DP Test.
18.	Inspection of Weld	:	Visual, D.P. Test & Macro Etching.
19.	Any other relevant Details	:	Diagonal- M0-U1 & M0-L1

Welding Procedure Specification Sheet for 106.7 m. Span Open Web Girder (Welded through type) 25 T Loading – 2008

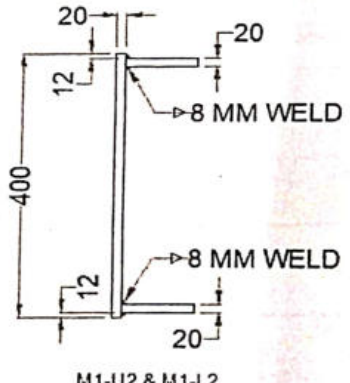
Name and address of Fabricator		:	M/s. Royal Infraconstru Ltd., Urli Industrial Growth Centre, Raipur – 493221 (C.G.)
Welding Procedure specification No.		:	ROYAL/SIVOK-RANGPO/106.7/11 dated 5/8/2022
01.	Drawing No.	:	RDSO/B-17185/R (G.A.)
02.	Welding Joint Description.	:	Fillet 8 mm
03.	Base Metal.	:	IS: 2062:2011 E-350 C.
04.	Welding Process	:	S.A.W.
05.	Welding Position.	:	Flat
06.	Welding Consumable.	:	
6.1	Electrode/Wire	Class	W2 of IRS M.39-2001.
		Type	Copper coated Solid Wire.
		Drying Method	N.A.
6.2	Flux		
		Class	F2 of IRS M.39 – 2001
		Type	Agglomerated.
		Drying Method	Recommendation as per manufacturer.
6.3	Shielding Gas	:	N.A.
07.	Base Metal Preparation	:	Fusion Faces and adjacent surfaces are cleaned and made free from Cracks, Notches, Mill scale, Grease, Paint, Rust etc., which may affected weld quality.
7.1	Joint design Details	:	
	(Sketch showing arrangements of parts, weld beat weld passes & their sequence etc.,) Component :- Diagonal-M1-U2 & M1-L2 Web With Flange		
7.2	Joint preparation	:	As Per IS:4353 – 1995, CI.7, IRS B1-2001, CI.17.3 & WBC – 2001.
08.	Welding Current	:	
		Type	DC
		Polarity	Reverse
09.	Welder qualification	:	As per IS: 7310/7307 (Part-I) – 1974
10.	Welding Parameters and technique	:	
10.1	Welding Parameters	:	

Weld Sequence No.	Electrodes wire dia. (mm)	Current (Amps)	Arc Voltage (Volt)	Wire Feed Speed (m/min)	Travel Speed (m/min)	Electrical Stick out (mm)	Gas Flow (l/min.)
1	4	530 – 570	28 – 32	1.4 – 1.8	0.35 – 0.50	15 – 20	N.A.

10.2	Welding Sequence and technique	:	Welding from run on to run off tabs at the free ends.


11.	Provision of run-on / run-off tabs	:	Yes
12.	Cleaning of weld bead before laying next weld bead	:	By brush cleaning & grinding
13.	Root preparation before welding other side of groove weld	:	N.A.
14.	Preheating and inter pass temperature	:	N.A. 110°C – 150°C
15.	Peening	:	N.A.
16.	Post Weld treatment	:	N.A.
17.	Rectification of weld defect	:	By re-welding after complete removal of defective weld & rectify the weld as per CI.32.2 of IS 9595-96, using B1 class of Electrodes of specn. IRS M.28-2017 after conducting DP Test.
18.	Inspection of Weld	:	Visual, D.P. Test & Macro Etching.
19.	Any other relevant Details	:	Diagonal-M1-U2 & M1-L2

Welding Procedure Specification Sheet for 106.7 m. Span Open Web Girder (Welded through type) 25 T Loading – 2008

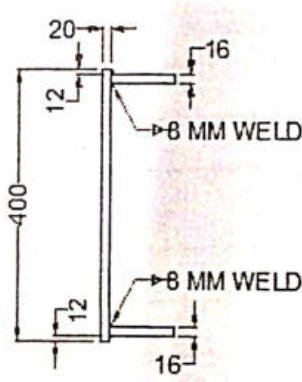Name and address of Fabricator		:	M/s. Royal Infraconstru Ltd., Urli Industrial Growth Centre, Raipur – 493221 (C.G.)
Welding Procedure specification No.		:	ROYAL/SIVOK-RANGPO/106.7/12 dated 5/8/2022
01.	Drawing No.	:	RDSO/B-17185/R (G.A.)
02.	Welding Joint Description.	:	Fillet 8 mm
03.	Base Metal.	:	IS: 2062:2011 E-350 C.
04.	Welding Process	:	S.A.W.
05.	Welding Position.	:	Flat
06.	Welding Consumable.		
6.1	Electrode/Wire	Class	W2 of IRS M.39-2001.
		Type	Copper coated Solid Wire.
		Drying Method	N.A.
6.2	Flux		
		Class	F2 of IRS M.39 – 2001
		Type	Agglomerated.
		Drying Method	Recommendation as per manufacturer.
6.3	Shielding Gas	:	N.A.
07.	Base Metal Preparation	:	Fusion Faces and adjacent surfaces are cleaned and made free from Cracks, Notches, Mill scale, Grease, Paint, Rust etc., which may affected weld quality.
7.1	Joint design Details	:	
	(Sketch showing arrangements of parts, weld beat weld passes & their sequence etc.,) Component :- Diagonal-M2-U3 , M2-L3 & M3-U4, M3-L4 & M4-U5,M4-L5 Web With Flange		 <p>M2-U3 , M2-L3 & M3-U4, M3-L4 & M4-U5, M4-L5</p>
7.2	Joint preparation	:	As Per IS:4353 – 1995, CI.7, IRS B1-2001, CI.17.3 & WBC – 2001.
08.	Welding Current	:	
	Type	:	DC
	Polarity	:	Reverse
09.	Welder qualification	:	As per IS: 7310/7307 (Part-1) – 1974
10.	Welding Parameters and technique	:	
10.1	Welding Parameters	:	


ROYAL-ITL (JV)

Weld Sequence No.	Electrodes wire dia. (mm)	Current (Amps)	Arc Voltage (Volt)	Wire Feed Speed (m/min)	Travel Speed (m/min)	Electrical Stick out (mm)	Gas Flow (l/min.)
1	4	530 - 570	28 - 32	1.4 - 1.8	0.35 - 0.50	15 - 20	N.A.

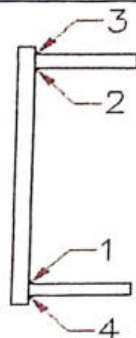10.2	Welding Sequence and technique	:	Welding from run on to run off tabs at the free ends.
			


11.	Provision of run-on / run-off tabs	:	Yes
12.	Cleaning of weld bead before laying next weld bead	:	By brush cleaning & grinding
13.	Root preparation before welding other side of groove weld	:	N.A.
14.	Preheating and inter pass temperature	:	N.A. 110°C - 150°C
15.	Peening	:	N.A.
16.	Post Weld treatment	:	N.A.
17.	Rectification of weld defect	:	By re-welding after complete removal of defective weld & rectify the weld as per CI.32.2 of IS 9595-96, using B1 class of Electrodes of specn. IRS M.28-2017 after conducting DP Test.
18.	Inspection of Weld	:	Visual, D.P. Test & Macro Etching.
19.	Any other relevant Details	:	Diagonal-M2-U3, M2-L3 & M3-U4, M3-L4 & M4-U5, M4-L5

Welding Procedure Specification Sheet for 106.7 m. Span Open Web Girder (Welded through type) 25 T Loading – 2008

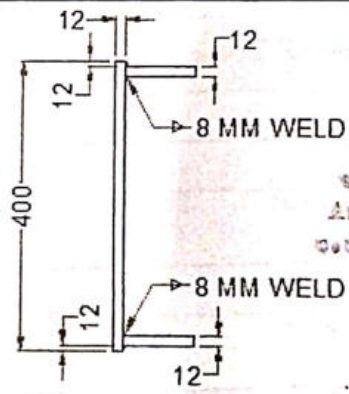Name and address of Fabricator		:	M/s. Royal Infraconstru Ltd., Urli Industrial Growth Centre, Raipur – 493221 (C.G.)
Welding Procedure specification No.		:	ROYAL/SIVOK-RANGPO/106.7/13 dated 5/8/2022
01.	Drawing No.	:	RDSO/B-17185/R (G.A.)
02.	Welding Joint Description.	:	Fillet 8 mm
03.	Base Metal.	:	IS: 2062:2011 E-350 C.
04.	Welding Process	:	S.A.W.
05.	Welding Position.	:	Flat
06.	Welding Consumable.	:	
6.1	Electrode/Wire	Class	: W2 of IRS M.39-2001.
		Type	: Copper coated Solid Wire.
		Drying Method	: N.A.
6.2	Flux		
		Class	: F2 of IRS M.39 – 2001
		Type	: Agglomerated.
		Drying Method	: Recommendation as per manufacturer.
6.3	Shielding Gas	:	N.A.
07.	Base Metal Preparation	:	Fusion Faces and adjacent surfaces are cleaned and made free from Cracks, Notches, Mill scale, Grease, Paint, Rust etc., which may affected weld quality.
7.1	Joint design Details	:	
	(Sketch showing arrangements of parts, weld beat weld passes & their sequence etc.,) Component :- Diagonal-M5-U6, M5-L6 & M6-U7, M6-L7 & M7-U8, M7-L8, M8-U9, M8-L9 Web With Flange		 <p>M5-U6, M5-L6 & M6-U7, M6-L7 & M7-U8, M7-L8 & M8-U9, M8-L9</p>
7.2	Joint preparation	:	As Per IS:4353 – 1995, CI.7, IRS B1-2001, CI.17.3 & WBC – 2001.
08.	Welding Current	:	
	Type	:	DC
	Polarity	:	Reverse
09.	Welder qualification	:	As per IS: 7310/7307 (Part-I) – 1974
10.	Welding Parameters and technique	:	
10.1	Welding Parameters	:	

Appendix-V (Ref.CI.26 of BI-2001)


Weld Sequence No.	Electrodes wire dia. (mm)	Current (Amps)	Arc Voltage (Volt)	Wire Feed Speed (m/min)	Travel Speed (m/min)	Electrical Stick out (mm)	Gas Flow (l/min.)
1	4	530 - 570	28 - 32	1.4 - 1.8	0.35 - 0.50	15 - 20	N.A.

10.2	Welding Sequence and technique	:	Welding from run on to run off tabs at the free ends.
			

11.	Provision of run-on / run-off tabs	:	Yes
12.	Cleaning of weld bead before laying next weld bead	:	By brush cleaning & grinding
13.	Root preparation before welding other side of groove weld	:	N.A.
14.	Preheating and inter pass temperature	:	N.A. 110°C - 150°C
15.	Peening	:	N.A.
16.	Post Weld treatment	:	N.A.
17.	Rectification of weld defect	:	By re-welding after complete removal of defective weld & rectify the weld as per CI.32.2 of IS 9595-96, using B1 class of Electrodes of specn. IRS M.28-2017 after conducting DP Test.
18.	Inspection of Weld	:	Visual, D.P. Test & Macro Etching.
19.	Any other relevant Details	:	Diagonal-M5-U6, M5-L6 & M6-U7, M6-L7 & M7-U8, M7-L8, M8-U9, M8-L9


217

Welding Procedure Specification Sheet for 106.7 m. Span Open Web Girder (Welded through type) 25 T Loading – 2008

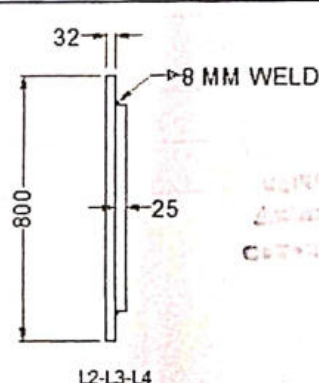Name and address of Fabricator		:	M/s. Royal Infraconstru Ltd., Ura Industrial Growth Centre, Raipur – 493221 (C.G.)
Welding Procedure specification No.		:	ROYAL/STVOK-RANGPO/106.7/14 dated 5/8/2022
01.	Drawing No.	:	RDSO/B-17185/R (G.A.)
02.	Welding Joint Description.	:	Fillet 8mm
03.	Base Metal.	:	IS: 2062:2011 E-350 C.
04.	Welding Process	:	S.A.W.
05.	Welding Position.	:	Flat
06.	Welding Consumable.		
6.1	Electrode/Wire	Class	W2 of IRS M.39-2001.
		Type	Copper coated Solid Wire.
		Drying Method	N.A.
6.2	Flux		
		Class	F2 of IRS M.39 – 2001
		Type	Agglomerated.
		Drying Method	Recommendation as per manufacturer.
6.3	Shielding Gas	:	N.A.
07.	Base Metal Preparation	:	Fusion Faces and adjacent surfaces are cleaned and made free from Cracks, Notches, Mill scale, Grease, Paint, Rust etc., which may affected weld quality.
7.1	Joint design Details	:	
	(Sketch showing arrangements of parts, weld beat weld passes & their sequence etc.,) Component :- Bottom Chord- L2-L3 & L3-L4 Web With Additional Plate		
7.2	Joint preparation	:	As Per IS: 4353 – 1995, CI.7, IRS B1-2001, CI.17.3 & WBC – 2001.
08.	Welding Current	:	
		Type	DC
		Polarity	Reverse
09.	Welder qualification	:	As per IS: 7310/7307 (Part-I) – 1974
10.	Welding Parameters and technique	:	
10.1	Welding Parameters	:	

Appendix-V (Ref.CI.26 of BI-2001)


Weld Sequence No.	Electrodes wire dia. (mm)	Current (Amps)	Arc Voltage (Volt)	Wire Feed Speed (m/min)	Travel Speed (m/min)	Electrical Stick out (mm)	Gas Flow (l/min.)
1	4	530 – 560	26 – 30	1.4 – 1.8	0.35 – 0.50	15 – 20	N.A.

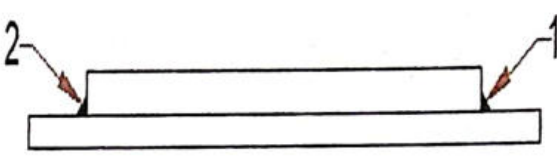10.2	Welding Sequence and technique	:	Welding from run on to run off tabs at the free ends.
			

11.	Provision of run-on / run-off tabs	:	Yes
12.	Cleaning of weld bead before laying next weld bead	:	By brush cleaning & grinding
13.	Root preparation before welding other side of groove weld	:	N.A.
14.	Preheating and inter pass temperature	:	N.A. 110°C - 150°C
15.	Peening	:	N.A.
16.	Post Weld treatment	:	N.A.
17.	Rectification of weld defect	:	By re-welding after complete removal of defective weld & rectify the weld as per CI.32.2 of IS 9595-96, using B1 class of Electrodes of specn. IRS M.28-2017 after conducting DP Test.
18.	Inspection of Weld	:	Visual, D.P. Test & Macro Etching.
19.	Any other relevant Details	:	Bottom Chord- L2-L3 & L 3-L4 Additional Plate


218

Welding Procedure Specification Sheet for 106.7 m. Span Open Web Girder (Welded through type) 25 T Loading - 2008

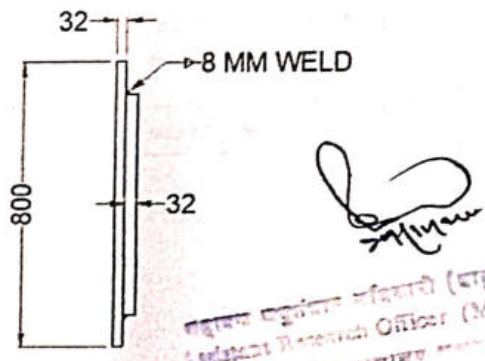Name and address of Fabricator		:	M/s. Royal Infraconstru Ltd., Urda Industrial Growth Centre, Raipur - 493221 (C.G.)
Welding Procedure specification No.		:	ROYAL/SIVOK-RANGPO/106.7/15 dated 5/8/2022
01.	Drawing No.	:	RDSO/B-17185/R (G.A.)
02.	Welding Joint Description.	:	Fillet 8 mm
03.	Base Metal.	:	IS: 2062:2011 E-350 C.
04.	Welding Process	:	S.A.W.
05.	Welding Position.	:	Flat
06.	Welding Consumable.		
6.1	Electrode/Wire	Class :	W2 of IRS M.39-2001.
		Type :	Copper coated Solid Wire.
		Drying Method :	N.A.
6.2	Flux		
		Class :	F2 of IRS M.39 - 2001
		Type :	Agglomerated.
		Drying Method :	Recommendation as per manufacturer.
6.3	Shielding Gas	:	N.A.
07.	Base Metal Preparation	:	Fusion Faces and adjacent surfaces are cleaned and made free from Cracks, Notches, Mill scale, Grease, Paint, Rust etc., which may affected weld quality.
7.1	Joint design Details	:	
	(Sketch showing arrangements of parts, weld beat weld passes & their sequence etc.,) Bottom Chord- L4-L5-L6 & L6-L7-L8 & L8-L9 Web With Additional Plate		 <p>L4-L5-L6 & L6-L7-L8 & L8-L9</p>
7.2	Joint preparation	:	As Per IS: 4353 - 1995, CI.7, IRS B1-2001, CI.17.3 & WBC - 2001.
08.	Welding Current	:	
		Type :	DC
		Polarity :	Reverse
09.	Welder qualification	:	As per IS: 7310/7307 (Part-I) - 1974
10.	Welding Parameters and technique	:	
10.1	Welding Parameters	:	

Appendix-V (Ref.CI.26 of BI-2001)


Weld Sequence No.	Electrodes wire dia. (mm)	Current (Amps)	Arc Voltage (Volt)	Wire Feed Speed (m/min)	Travel Speed (m/min)	Electrical Stick out (mm)	Gas Flow (l/min.)
1	4	560 - 600	28 - 32	2.3 - 3.2	0.22 - 0.32	15 - 20	N.A.

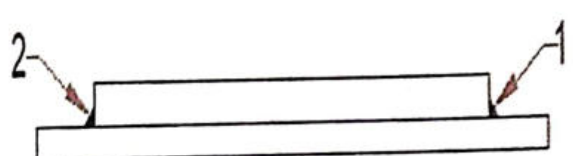10.2	Welding Sequence and technique	:	Welding from run on to run off tabs at the free ends.
			


11.	Provision of run-on / run-off tabs	:	Yes
12.	Cleaning of weld bead before laying next weld bead	:	By brush cleaning & grinding
13.	Root preparation before welding other side of groove weld	:	N.A.
14.	Preheating and inter pass temperature	:	N.A. 110°C - 150°C
15.	Peening	:	N.A.
16.	Post Weld treatment	:	N.A.
17.	Rectification of weld defect	:	By re-welding after complete removal of defective weld & rectify the weld as per CI.32.2 of IS 9595-96, using B1 class of Electrodes of spec. IRS M.28-2017 after conducting DP Test.
18.	Inspection of Weld	:	Visual, D.P. Test & Macro Etching.
19.	Any other relevant Details	:	Bottom Chord- L4-L5-L6 & L6-L7-L8 & L8 -L9 Additional Plate

Appendix-V (Ref.CI.26 of B I-2001).

Welding Procedure Specification Sheet for 106.7 m. Span Open Web Girder (Welded through type) 25 T Loading – 2008

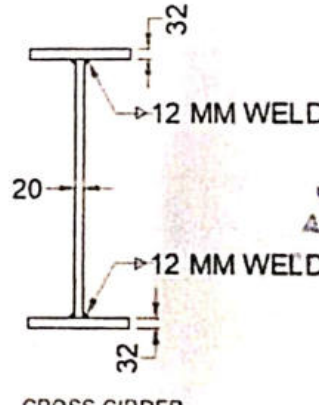
Name and address of Fabricator		:	M/s. Royal Infraconstru Ltd., Uda Industrial Growth Centre, Raipur – 493221 (C.G.)
Welding Procedure specification No.		:	ROYAL/STVOK-RANGPO/106.7/16 dated 5/8/2022
01.	Drawing No.	:	RDSO/B-17185/R (G.A.)
02.	Welding Joint Description.	:	Fillet 12mm
03.	Base Metal.	:	IS: 2062:2011 E-350 C.
04.	Welding Process	:	S.A.W.
05.	Welding Position.	:	Flat
06.	Welding Consumable.	:	
6.1	Electrode/Wire	Class :	W2 of IRS M.39-2001.
		Type :	Copper coated Solid Wire.
		Drying Method :	N.A.
6.2	Flux		
		Class :	F2 of IRS M.39 – 2001
		Type :	Agglomerated.
		Drying Method :	Recommendation as per manufacturer.
6.3	Shielding Gas	:	N.A.
07.	Base Metal Preparation	:	Fusion Faces and adjacent surfaces are cleaned and made free from Cracks, Notches, Mill scale, Grease, Paint, Rust etc., which may affected weld quality.
7.1	Joint design Details	:	
	(Sketch showing arrangements of parts, weld bead weld passes & their sequence etc.,) Component :- Cross Girder Web with Flange		
7.2	Joint preparation	:	As Per IS: 4353 – 1995, CI.7, IRS B1-2001, CI.17.3 & WSC – 2001.
08.	Welding Current	:	
	Type	:	DC
	Polarity	:	Reverse
09.	Welder qualification	:	As per IS: 7310/7307 (Part-I) – 1974
10.	Welding Parameters and technique	:	
10.1	Welding Parameters	:	

Weld Sequence No.	Electrodes wire dia. (mm)	Current (Amps)	Arc Voltage (Volt)	Wire Feed Speed (m/min)	Travel Speed (m/min)	Electrical Stick out (mm)	Gas Flow (l/min.)
1	4	530 - 560	26 - 30	1.4 - 1.8	0.35 - 0.50	15 - 20	N.A.
2	4	530 - 560	26 - 30	1.4 - 1.8	0.35 - 0.50	15 - 20	N.A.

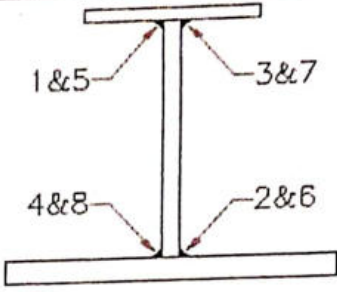
10.2	Welding Sequence and technique	:	Welding from run on to run off tabs at the free ends.
			

11.	Provision of run-on / run-off tabs	:	Yes
12.	Cleaning of weld bead before laying next weld bead	:	By brush cleaning & grinding
13.	Root preparation before welding other side of groove weld	:	N.A.
14.	Preheating and inter pass temperature	:	N.A. 110°C - 180°C
15.	Peening	:	N.A.
16.	Post Weld treatment	:	N.A.
17.	Rectification of weld defect	:	By re-welding after complete removal of defective weld & rectify the weld as per CI.32.2 of IS 9595-96, using B1 class of Electrodes of specn. IRS M.28-2017 after conducting DP Test.
18.	Inspection of Weld	:	Visual, D.P. Test & Macro Etching.
19.	Any other relevant Details	:	Cross Girder

Welding Procedure Specification Sheet for 106.7 m. Span Open Web Girder (Welded through type) 25 T Loading – 2008

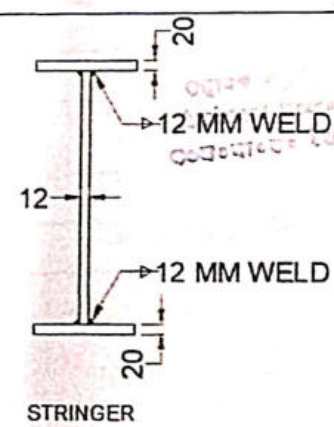Name and address of Fabricator		:	M/s. Royal Infraconstru Ltd., Urli Industrial Growth Centre, Raipur – 493221 (C.G.)
Welding Procedure specification No.		:	ROYAL/SIVOK-RANGPO/106.7/17 dated 5/8/2022
01.	Drawing No.	:	RDSO/B-17185/R (G.A.)
02.	Welding Joint Description.	:	Fillet 12mm
03.	Base Metal.	:	IS: 2062:2011 E-350 C.
04.	Welding Process	:	S.A.W.
05.	Welding Position.	:	Flat
06.	Welding Consumable.	:	
6.1	Electrode/Wire	Class	: W2 of IRS M.39-2001.
		Type	: Copper coated Solid Wire.
		Drying Method	: N.A.
6.2	Flux		
		Class	: F2 of IRS M.39 – 2001
		Type	: Agglomerated.
		Drying Method	: Recommendation as per manufacturer.
6.3	Shielding Gas	:	N.A.
07.	Base Metal Preparation	:	Fusion Faces and adjacent surfaces are cleaned and made free from Cracks, Notches, Mill scale, Grease, Paint, Rust etc., which may affected weld quality.
7.1	Joint design Details	:	
	(Sketch showing arrangements of parts, weld bead weld passes & their sequence etc.,) Component :- Stringer Web with Flange.		 <p>20</p> <p>12</p> <p>12 MM WELD</p> <p>12 MM WELD</p> <p>20</p> <p>STRINGER</p>
7.2	Joint preparation	:	As Per IS: 4353 – 1995, CI.7, IRS B1-2001, CI.17.3 & WBC – 2001.
08.	Welding Current	:	
		Type	: DC
		Polarity	: Reverse
09.	Welder qualification	:	As per IS: 7310/7307 (Part-I) – 1974
10.	Welding Parameters and technique	:	
10.1	Welding Parameters	:	ROYAL-IITL (JV)


Weld Sequence No.	Electrodes wire dia. (mm)	Current (Amps)	Arc Voltage (Volt)	Wire Feed Speed (m/min)	Travel Speed (m/min)	Electrical Stick out (mm)	Gas Flow (l/min.)
1	4	540 - 580	28 - 32	2.0 - 2.8	0.24 - 0.35	15 - 20	N.A.
2	4	540 - 580	28 - 32	2.0 - 2.8	0.24 - 0.35	15 - 20	N.A.

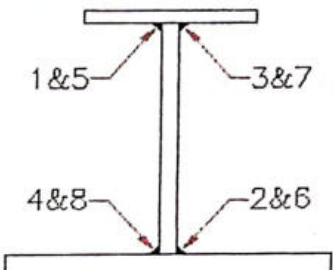10.2	Welding Sequence and technique	:	Welding from run on to run off tabs at the free ends.
			


11.	Provision of run-on / run-off tabs	:	Yes
12.	Cleaning of weld bead before laying next weld bead	:	By brush cleaning & grinding
13.	Root preparation before welding other side of groove weld	:	N.A.
14.	Preheating and inter pass temperature	:	N.A. 110°C - 150°C
15.	Peening	:	N.A.
16.	Post Weld treatment	:	N.A.
17.	Rectification of weld defect	:	By re-welding after complete removal of defective weld & rectify the weld as per CI.32.2 of IS 9595-96, using B1 class of Electrodes of specn. IRS M.28-2017 after conducting DP Test.
18.	Inspection of Weld	:	Visual, D.P. Test & Macro etching
19.	Any other relevant Details	:	Stringer Web with Flange.

Appendix-V (Ref.CI.26 of B I-2001).

Welding Procedure Specification Sheet for 106.7 m. Span Open Web Girder (Welded through type) 25 T Loading – 2008

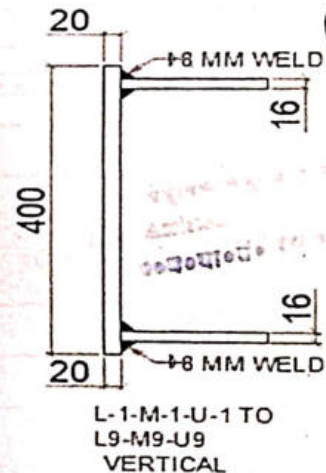Name and address of Fabricator	:	M/s. Royal Infraconstru Ltd., Urli Industrial Growth Centre, Raipur – 493221 (C.G.)
Welding Procedure specification No.	:	ROYAL/SIVOK-RANGPO/106.7/18 dated 5/8/2022
01. Drawing No.	:	RDSO/B-17185/R (G.A.)
02. Welding Joint Description.	:	Fillet 08mm
03. Base Metal.	:	IS: 2062:2011 E-350 C.
04. Welding Process	:	S.A.W.
05. Welding Position.	:	Flat
06. Welding Consumable.	:	
6.1 Electrode/Wire	Class :	W2 of IRS M.39-2001.
	Type :	Copper coated Solid Wire.
	Drying Method :	N.A.
6.2 Flux	:	
	Class :	F2 of IRS M.39 – 2001
	Type :	Agglomerated.
	Drying Method :	Recommendation as per manufacturer.
6.3 Shielding Gas	:	N.A.
07. Base Metal Preparation	:	Fusion Faces and adjacent surfaces are cleaned and made free from Cracks, Notches, Mill scale, Grease, Paint, Rust etc., which may affected weld quality.
7.1 Joint design Details	:	
(Sketch showing arrangements of parts, weld beat weld passes & their sequence etc.,) Component :- All Vertical Web with Flange.		 <p>L-1-M-1-U-1 TO L9-M9-U9 VERTICAL</p>
7.2 Joint preparation	:	As Per IS: 4353 – 1995, CI.7, IRS B1-2001, CI.17.3 & WBC – 2001.
08. Welding Current	:	
	Type :	DC
	Polarity :	Reverse
09. Welder qualification	:	As per IS: 7310/7307 (Part-I) – 1974
10. Welding Parameters and technique	:	
10.1 Welding Parameters	:	


Weld Sequence No.	Electrodes wire dia. (mm)	Current (Amps)	Arc Voltage (Volt)	Wire Feed Speed (m/min)	Travel Speed (m/min)	Electrical Stick out (mm)	Gas Flow (l/min.)
1	4	540 - 580	28 - 32	2.0 - 2.8	0.24 - 0.35	15 - 20	N.A.

10.2	Welding Sequence and technique	:	Welding from run on to run off tabs at the free ends.
			

11.	Provision of run-on / run-off tabs	:	Yes
12.	Cleaning of weld bead before laying next weld bead	:	By brush cleaning & grinding
13.	Root preparation before welding other side of groove weld	:	N.A.
14.	Preheating and inter pass temperature	:	N.A. 110°C - 150°C
15.	Peening	:	N.A.
16.	Post Weld treatment	:	N.A.
17.	Rectification of weld defect	:	By re-welding after complete removal of defective weld & rectify the weld as per CI.32.2 of IS 9595-96, using B1 class of Electrodes of specn. IRS M.28-2017 after conducting DP Test.
18.	Inspection of Weld	:	Visual, D.P. Test & Macro etching
19.	Any other relevant Details	:	Vertical Web with Flange.


222

Welding Procedure Specification Sheet for 106.7 m. Span Open Web Girder (Welded through type) 25 T Loading – 2008

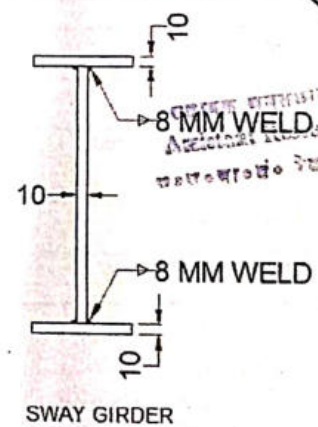Name and address of Fabricator		:	M/s. Royal Infraconstru Ltd., Urli Industrial Growth Centre, Raipur – 493221 (C.G.)
Welding Procedure specification No.		:	ROYAL/SIVOK-RANGPO/106.7/19 dated 5/8/2022
01.	Drawing No.	:	RDSO/B-17185/R (G.A.)
02.	Welding Joint Description.	:	Fillet 08mm
03.	Base Metal.	:	IS: 2062:2011 E-350 C.
04.	Welding Process	:	S.A.W.
05.	Welding Position.	:	Flat
06.	Welding Consumable.	:	
6.1	Electrode/Wire	Class :	W2 of IRS M.39-2001.
		Type :	Copper coated Solid Wire.
		Drying Method :	N.A.
6.2	Flux	Class :	F2 of IRS M.39 – 2001
		Type :	Agglomerated.
		Drying Method :	Recommendation as per manufacturer.
6.3	Shielding Gas	:	N.A.
07.	Base Metal Preparation	:	Fusion Faces and adjacent surfaces are cleaned and made free from Cracks, Notches, Mill scale, Grease, Paint, Rust etc., which may affected weld quality.
7.1	Joint design Details	:	
	(Sketch showing arrangements of parts, weld beat weld passes & their sequence etc.,) Component :- Sway Girder Web with Flange.		 <p>SWAY GIRDER</p>
7.2	Joint preparation	:	As Per IS: 4353 – 1995, CI.7, IRS B1-2001, CI.17.3 & WBC – 2001.
08.	Welding Current	:	
		Type :	DC
		Polarity :	Reverse
09.	Welder qualification	:	As per IS: 7310/7307 (Part-I) – 1974
10.	Welding Parameters and technique	:	
10.1	Welding Parameters	:	

ROYAL - I/TL (JV)


Weld Sequence No.	Electrodes wire dia. (mm)	Current (Amps)	Arc Voltage (Volt)	Wire Feed Speed (m/min)	Travel Speed (m/min)	Electrical Stick out (mm)	Gas Flow (l/min.)
1	4	540 - 580	28 - 32	2.0 - 2.8	0.24 - 0.35	15 - 20	N.A.

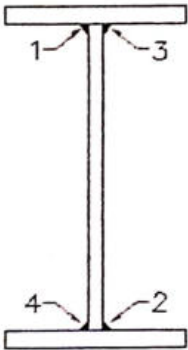10.2	Welding Sequence and technique	:	Welding from run on to run off tabs at the free ends.
			


11.	Provision of run-on / run-off tabs	:	Yes
12.	Cleaning of weld bead before laying next weld bead	:	By brush cleaning & grinding
13.	Root preparation before welding other side of groove weld	:	N.A.
14.	Preheating and inter pass temperature	:	N.A. 110°C - 150°C
15.	Peening	:	N.A.
16.	Post Weld treatment	:	N.A.
17.	Rectification of weld defect	:	By re-welding after complete removal of defective weld & rectify the weld as per CI.32.2 of IS 9595-96, using B1 class of Electrodes of specn. IRS M.28-2017 after conducting DP Test.
18.	Inspection of Weld	:	Visual, D.P. Test & Macro etching
19.	Any other relevant Details	:	Sway Girder Web with Flange.

223

Welding Procedure Specification Sheet for 106.7 m. Span Open Web Girder (Welded through type) 25 T Loading – 2008

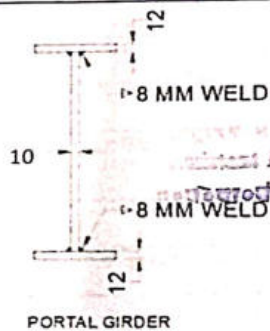Name and address of Fabricator		:	M/s. Royal Infraconstru Ltd., Urta Industrial Growth Centre, Raipur – 493221 (C.G.)
Welding Procedure specification No.		:	ROYAL/STVOK-RANGPO/106.7/20 dated 5/8/2022
01.	Drawing No.	:	RDSO/B-17185/R (G.A.)
02.	Welding Joint Description.	:	Fillet 08mm
03.	Base Metal.	:	IS: 2062:2011 E-350 C.
04.	Welding Process	:	S.A.W.
05.	Welding Position.	:	Flat
06.	Welding Consumable.	:	
6.1	Electrode/Wire	Class :	W2 of IRS M.39-2001.
		Type :	Copper coated Solid Wire.
		Drying Method :	N.A.
6.2	Flux		
		Class :	F2 of IRS M.39 – 2001
		Type :	Agglomerated.
		Drying Method :	Recommendation as per manufacturer.
6.3	Shielding Gas	:	N.A.
07.	Base Metal Preparation	:	Fusion Faces and adjacent surfaces are cleaned and made free from Cracks, Notches, Mill scale, Grease, Paint, Rust etc., which may affected weld quality.
7.1	Joint design Details	:	
	(Sketch showing arrangements of parts, weld beat weld passes & their sequence etc.,) Component :- Portal Web with Flange.		 <p>PORTAL GIRDER</p>
7.2	Joint preparation	:	As Per IS: 4353 – 1995, CI.7, IRS B1-2001, CI.17.3 & WBC – 2001.
08.	Welding Current	:	
		Type :	DC
		Polarity :	Reverse
09.	Welder qualification	:	As per IS: 7310/7307 (Part-I) – 1974
10.	Welding Parameters and technique	:	
10.1	Welding Parameters	:	

Weld Sequence No.	Electrodes wire dia. (mm)	Current (Amps)	Arc Voltage (Volt)	Wire Feed Speed (m/min)	Travel Speed (m/min)	Electrical Stick out (mm)	Gas Flow (l/min.)
1	4	540 - 580	28 - 32	2.0 - 2.8	0.24 - 0.35	15 - 20	N.A.

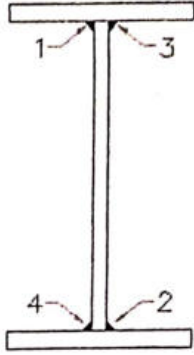
10.2	Welding Sequence and technique	:	Welding from run on to run off tabs at the free ends.
			

11.	Provision of run-on / run-off tabs	:	Yes
12.	Cleaning of weld bead before laying next weld bead	:	By brush cleaning & grinding
13.	Root preparation before welding other side of groove weld	:	N.A.
14.	Preheating and inter pass temperature	:	N.A. 110°C ~ 130°C
15.	Peening	:	N.A.
16.	Post Weld treatment	:	N.A.
17.	Rectification of weld defect	:	By re-welding after complete removal of defective weld & rectify the weld as per CI.32.2 of IS 9595-96, using B1 class of Electrodes of specn. IRS M.28-2017 after conducting DP Test.
18.	Inspection of Weld	:	Visual, D.P. Test & Macro etching
19.	Any other relevant Details	:	Portal Web with Flange.

Welding Procedure Specification Sheet for 106.7 m. Span Open Web Girder (Welded through type) 25 T Loading – 2008

Name and address of Fabricator		:	M/s. Royal Infraconstru Ltd., Urla Industrial Growth Centre, Raipur – 493221 (C.G.)
Welding Procedure specification No.		:	ROYAL/SIVOK-RANGPO/106.7/21 dated 5/8/2022
01.	Drawing No.	:	RDSO/B-17185/R (G.A.)
02.	Welding Joint Description.	:	Fillet 06mm
03.	Base Metal.	:	IS: 2062:2011 E-350 C.
04.	Welding Process	:	S.A.W.
05.	Welding Position.	:	Flat
06.	Welding Consumable.	:	
6.1	Electrode/Wire	Class :	W2 of IRS M.39-2001.
		Type :	Copper coated Solid Wire.
		Drying Method :	N.A.
6.2	Flux		
		Class :	F2 of IRS M.39 – 2001
		Type :	Agglomerated.
		Drying Method :	Recommendation as per manufacturer
6.3	Shielding Gas	:	N.A.
07.	Base Metal Preparation	:	Fusion Faces and adjacent surfaces are cleaned and made free from Cracks, Notches, Mill scale, Grease, Paint, Rust etc., which may affected weld quality.
7.1	Joint design Details	:	
	(Sketch showing arrangements of parts, weld beat weld passes & their sequence etc.,) Component :- Top Lateral Bracing LO Joint Bracket		
7.2	Joint preparation	:	As Per IS: 4353 – 1995, CI.7, IRS B1-2001, CI.17.3 & WBC – 2001.
08.	Welding Current	:	
	Type	:	DC
	Polarity	:	Reverse
09.	Welder qualification	:	As per IS: 7310/7307 (Part-I) – 1974
10.	Welding Parameters and technique	:	
10.1	Welding Parameters	:	

Weld Sequence No.	Electrodes wire dia. (mm)	Current (Amps)	Arc Voltage (Volt)	Wire Feed Speed (m/min)	Travel Speed (m/min)	Electrical Stick out (mm)	Gas Flow (l/min.)
1	4	540 - 580	28 - 32	2.0 - 2.8	0.24 - 0.35	15 - 20	N.A.

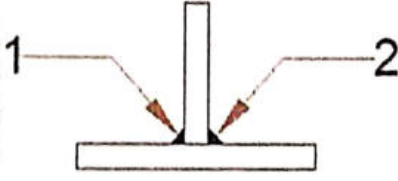10.2	Welding Sequence and technique	:	Welding from run on to run off tabs at the free ends.
			

11.	Provision of run-on / run-off tabs	:	Yes
12.	Cleaning of weld bead before laying next weld bead	:	By brush cleaning & grinding
13.	Root preparation before welding other side of groove weld	:	N.A.
14.	Preheating and inter pass temperature	:	N.A. 110°C - 150°C
15.	Peening	:	N.A.
16.	Post Weld treatment	:	N.A.
17.	Rectification of weld defect	:	By re-welding after complete removal of defective weld & rectify the weld as per CI.32.2 of IS 9595-96, using B1 class of Electrodes of specn. IRS M.28-2017 after conducting DP Test.
18.	Inspection of Weld	:	Visual, D.P. Test & Macro etching
19.	Any other relevant Details	:	Top Lateral Bracing


Welding Procedure Specification Sheet for 106.7 m. Span Open Web Girder (Welded through type) 25 T Loading – 2008

Name and address of Fabricator		:	M/s. Royal Infraconstru Ltd., Urli Industrial Growth Centre, Raipur – 493221 (C.G.)
Welding Procedure specification No.		:	ROYAL/SIVOK-RANGPO/106.7/22 dated 5/8/2022
01.	Drawing No.	:	RDSO/B-17185/R (G.A.)
02.	Welding Joint Description.	:	Fillet 8 mm
03.	Base Metal.	:	IS: 2062:2011 E-350 C.
04.	Welding Process	:	GMAW
05.	Welding Position.	:	Horizontal
06.	Welding Consumable.		
6.1	Electrode/Wire	Class :	I of IRS M 46-2013.
		Type :	Copper coated Solid Wire.
		Drying Method :	N.A.
6.2	Flux		
		Class :	N.A.
		Type :	N.A.
		Drying Method :	N.A.
6.3	Shielding Gas	:	CO2
07.	Base Metal Preparation	:	Fusion Faces and adjacent surfaces are cleaned and made free from Cracks, Notches, Mill scale, Grease, Paint, Rust etc., which may affected weld quality.
7.1	Joint design Details	:	
	(Sketch showing arrangements of parts, weld beat weld passes & their sequence etc.,) Component :- Corner bracket Rib Plate for X Girder V type groove to be fill up by weld material in both plate.		
7.2	Joint preparation	:	As Per IS: 10178 – 1995, CL9, IRS B1-2001, CI.17.3 & WBC – 2001.
08.	Welding Current	:	
	Type	:	DC
	Polarity	:	Reverse
09.	Welder qualification	:	As per IS: 7310/7307 (Part-I) – 1974
10.	Welding Parameters and technique	:	
10.1	Welding Parameters	:	

ROYAL IFL (JV)


Appendix-V (Ref.CI.26 of BI-2001)

Weld Sequence No.	Electrodes wire dia. (mm)	Current (Amps)	Arc Voltage (Volt)	Wire Feed Speed (m/min)	Travel Speed (m/min)	Electrical Stick out (mm)	Gas Flow (l/min.)
1	1.2	180 - 220	24 - 28	1.1 - 2.2	N.A.	13 - 18	15 - 20
2	1.2	180 - 220	24 - 28	1.1 - 2.2	N.A.	13 - 18	15 - 20

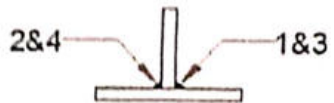10.2	Welding Sequence and technique	:	
			

11.	Provision of run-on / run-off tabs	:	N.A.
12.	Cleaning of weld bead before laying next weld bead	:	By brush cleaning & grinding
13.	Root preparation before welding other side of groove weld	:	N.A.
14.	Preheating and inter pass temperature	:	N.A. 110°C - 150°C
15.	Peening	:	N.A.
16.	Post Weld treatment	:	N.A.
17.	Rectification of weld defect	:	By re-welding after complete removal of defective weld & rectify the weld as per CI.32.2 of IS 9595-96, using B1 class of Electrodes of spec. IRS M.28-2017 after conducting DP Test.
18.	Inspection of Weld	:	Visual & D.P. Test.
19.	Any other relevant Details	:	Rib of Corner Bracket

Weld Sequence No.	Electrodes wire dia. (mm)	Current (Amps)	Arc Voltage (Volt)	Wire Feed Speed (m/min)	Travel Speed (m/min)	Electrical Stick out (mm)	Gas Flow (l/min.)
1	1.2	180 - 220	24 - 28	1.4 - 2.2	N.A.	13 - 18	15 - 20
2	1.2	200 - 220	24 - 28	1.6 - 2.4	N.A.	13 - 18	15 - 20
3	1.2	180 - 220	24 - 28	1.4 - 2.2	N.A.	13 - 18	15 - 20

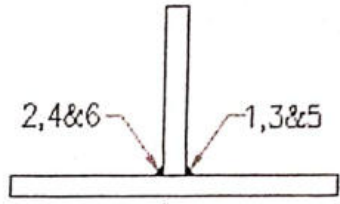10.2	Welding Sequence and technique	:	
			

11.	Provision of run-on / run-off tabs	:	N.A.
12.	Cleaning of weld bead before laying next weld bead	:	Yes
13.	Root preparation before welding other side of groove weld	:	N.A.
14.	Preheating and inter pass temperature	:	N.A. 110°C - 150°C
15.	Peening	:	N.A.
16.	Post Weld treatment	:	N.A.
17.	Rectification of weld defect	:	By re-welding after complete removal of defective weld & rectify the weld as per Cl.32.2 of IS 9595-96, using B1 class of Electrodes of specn. IRS M.28-2017 after conducting DP Test.
18.	Inspection of Weld	:	Visual & D.P. Test.
19.	Any other relevant Details	:	End Plate of Cross Girder.


227

Welding Procedure Specification Sheet for 106.7 m. Span Open Web Girder (Welded through type) 25 T Loading – 2008

Name and address of Fabricator		:	M/s. Royal Infraconstru Ltd., Uria Industrial Growth Centre, Raipur – 493221 (C.G.)
Welding Procedure specification No.		:	ROYAL/SIVOK-RANGPO/106.7/24 dated 5/8/2022
01.	Drawing No.	:	RDSO/B-17185/R (G.A.)
02.	Welding Joint Description.	:	Fillet 6mm
03.	Base Metal.	:	IS: 2062:2011 E-350 C.
04.	Welding Process	:	GMAW
05.	Welding Position.	:	Horizontal
06.	Welding Consumable	:	
6.1	Electrode/Wire	Class :	I of IRS M 46-2013.
		Type :	Copper coated Solid Wire.
		Drying Method :	N.A.
6.2	Flux		
		Class :	N.A.
		Type :	N.A
		Drying Method :	N.A
6.3	Shielding Gas	:	CO2
07.	Base Metal Preparation	:	Fusion Faces and adjacent surfaces are cleaned and made free from Cracks, Notches, Mill scale, Grease, Paint, Rust etc., which may affected weld quality.
7.1	Joint design Details	:	
	(Sketch showing arrangements of parts, weld beat weld passes & their sequence etc.,) Component :- Batten Plate With Flange Diaph. Plate With Web		
7.2	Joint preparation	:	As Per IS: 10178 – 1995, CL.9, IRS B1-2001, CL.17.3 & WBC – 2001.
08.	Welding Current	:	
	Type	:	DC
	Polarity	:	Reverse
09.	Welder qualification	:	As per IS: 7310/7307 (Part-I) – 1974
10.	Welding Parameters and technique	:	
10.1	Welding Parameters	:	

Appendix-V (Ref.CI.26 of BI-2001)


Weld Sequence No.	Electrodes wire dia. (mm)	Current (Amps)	Arc Voltage (Volt)	Wire Feed Speed (m/min)	Travel Speed (m/min)	Electrical Stick out (mm)	Gas Flow (l/min.)
1	1.2	180 - 220	24 - 28	1.4 - 2.2	N.A.	13 - 18	15 - 20

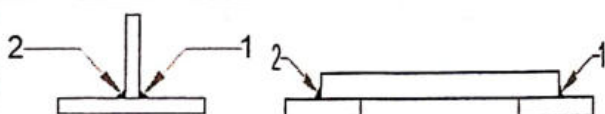10.2	Welding Sequence and technique	:	
------	--------------------------------	---	---

11.	Provision of run-on / run-off tabs	:	N.A.
12.	Cleaning of weld bead before laying next weld bead	:	By brush cleaning & grinding
13.	Root preparation before welding other side of groove weld	:	N.A.
14.	Preheating and inter pass temperature	:	N.A. 110°C - 150°C
15.	Peening	:	N.A.
16.	Post Weld treatment	:	N.A.
17.	Rectification of weld defect	:	By re-welding after complete removal of defective weld & rectify the weld as per CI.32.2 of IS 9595-96, using B1 class of Electrodes of specn. IRS M.28-2017 after conducting DP Test.
18.	Inspection of Weld	:	Visual & D.P. Test.
19.	Any other relevant Details	:	Batten Plate & End Diaph.


228

Welding Procedure Specification Sheet for 106.7 m. Span Open Web Girder (Welded through type) 25 T Loading – 2008

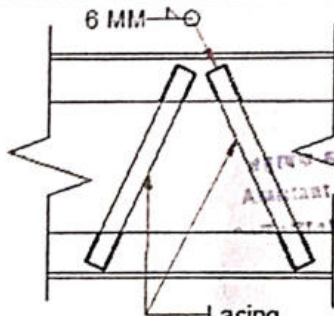Name and address of Fabricator		:	M/s. Royal Infraconstru Ltd., Urli Industrial Growth Centre, Raipur – 493221 (C.G.)
Welding Procedure specification No.		:	ROYAL/SIVOK-RANGPO/106.7/25 dated 5/8/2022
01.	Drawing No.	:	RDSO/B-17185/R (G.A.)
02.	Welding Joint Description.	:	Fillet 6mm
03.	Base Metal.	:	IS: 2062:2011 E-350 C.
04.	Welding Process	:	GMAW
05.	Welding Position.	:	Horizontal
06.	Welding Consumable.	:	
6.1	Electrode/Wire	Class :	I of IRS M 46-2013.
		Type :	Copper coated Solid Wire.
		Drying Method :	N.A.
6.2	Flux		
		Class :	N.A.
		Type :	N.A.
		Drying Method :	N.A.
6.3	Shielding Gas	:	CO2
07.	Base Metal Preparation	:	Fusion Faces and adjacent surfaces are cleaned and made free from Cracks, Notches, Mill scale, Grease, Paint, Rust etc., which may affected weld quality.
7.1	Joint design Details	:	
	(Sketch showing arrangements of parts, weld beat weld passes & their sequence etc.,) Component :- Lacing (Flat-20x80) With Flange of Top Chord & End Raker Lacing (Flat-16x80) With Flange of Diagonal Lacing (Flat-16x80) With Flange of Vertical		 <p>6 MM</p> <p>Lacing FLAT-20X80 FLAT-16X80</p> <p>FOR TOP CHORD, END RAKER & DIAGONAL Vertical</p>
7.2	Joint preparation	:	As Per IS: 10178 – 1995, CL9, IRS B1-2001, CI.17.3 & WBC – 2001.
08.	Welding Current	:	
	Type	:	DC
	Polarity	:	Reverse
09.	Welder qualification	:	As per IS: 7310/7307 (Part-I) – 1974
10.	Welding Parameters and technique	:	
10.1	Welding Parameters	:	

ROYAL - I/TL (JV)

Weld Sequence No.	Electrodes wire dia. (mm)	Current (Amps)	Arc Voltage (Volt)	Wire Feed Speed (m/min)	Travel Speed (m/min)	Electrical Stick out (mm)	Gas Flow (l/min.)
1	1.2	180 - 220	24 - 28	1.4 - 2.2	N.A.	13 - 18	15 - 20

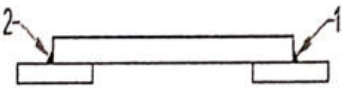10.2	Welding Sequence and technique	:	
			


11.	Provision of run-on / run-off tabs	:	N.A.
12.	Cleaning of weld bead before laying next weld bead	:	By brush cleaning & grinding
13.	Root preparation before welding other side of groove weld	:	N.A.
14.	Preheating and inter pass temperature	:	N.A. 110°C - 150°C
15.	Peening	:	N.A.
16.	Post Weld treatment	:	N.A.
17.	Rectification of weld defect	:	By re-welding after complete removal of defective weld & rectify the weld as per Cl.32.2 of IS 9595-96, using B1 class of Electrodes of specn. IRS M.28-2017 after conducting DP Test.
18.	Inspection of Weld	:	Visual & D.P. Test.
19.	Any other relevant Details	:	Lacing

229

Welding Procedure Specification Sheet for 106.7 m. Span Open Web Girder (Welded through type) 25 T Loading – 2008

Name and address of Fabricator		:	M/s. Royal Infraconstru Ltd., Urla Industrial Growth Centre, Raipur – 493221 (C.G.)
Welding Procedure specification No.		:	ROYAL/SIVOK-RANGPO/106.7/26 dated 5/8/2022
01.	Drawing No.	:	RDSO/B-17185/R (G.A.)
02.	Welding Joint Description.	:	Fillet 10mm
03.	Base Metal.	:	IS: 2062:2011 E-350 C.
04.	Welding Process	:	GMAW
05.	Welding Position.	:	Horizontal
06.	Welding Consumable.	:	
6.1	Electrode/Wire	Class :	I of IRS M 46-2013.
		Type :	Copper coated Solid Wire.
		Drying Method :	N.A.
6.2	Flux		
		Class :	N.A.
		Type :	N.A.
		Drying Method :	N.A.
6.3	Shielding Gas	:	CO2
07.	Base Metal Preparation	:	Fusion Faces and adjacent surfaces are cleaned and made free from Cracks, Notches, Mill scale, Grease, Paint, Rust etc., which may affected weld quality.
7.1	Joint design Details	:	
	(Sketch showing arrangements of parts, weld beat weld passes & their sequence etc.,) Component :- Corner Bracket for X girder V type groove to be fill up by weld material in flange & end plate.		
7.2	Joint preparation	:	As Per IS: 10178 – 1995, CL.9, IRS B1-2001, CI.17.3 & WBC – 2001.
08.	Welding Current	:	
		Type :	DC
		Polarity :	Reverse
09.	Welder qualification	:	As per IS: 7310/7307 (Part-I) – 1974
10.	Welding Parameters and technique	:	
10.1	Welding Parameters	:	

Weld Sequence No.	Electrodes wire dia. (mm)	Current (Amps)	Arc Voltage (Volt)	Wire Feed Speed (m/min)	Travel Speed (m/min)	Electrical Stick out (mm)	Gas Flow (l/min.)
1	1.2	180 - 220	24 - 28	1.4 - 2.2	N.A.	13 - 18	15 - 20
2	1.2	200 - 220	24 - 28	1.6 - 2.4	N.A.	13 - 18	15 - 20
3	1.2	180 - 220	24 - 28	1.4 - 2.2	N.A.	13 - 18	15 - 20

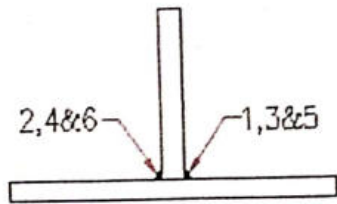10.2	Welding Sequence and technique	:	
			

11.	Provision of run-on / run-off tabs	:	N.A.
12.	Cleaning of weld bead before laying next weld bead	:	Yes
13.	Root preparation before welding other side of groove weld	:	N.A.
14.	Preheating and inter pass temperature	:	N.A. 110°C - 150°C
15.	Peening	:	N.A.
16.	Post Weld treatment	:	N.A.
17.	Rectification of weld defect	:	By re-welding after complete removal of defective weld & rectify the weld as per CI.32.2 of IS 9595-96, using B1 class of Electrodes of specn. IRS M.28-2017 after conducting DP Test.
18.	Inspection of Weld	:	Visual & D.P. Test.
19.	Any other relevant Details	:	Corner Bracket for X girder


230

Welding Procedure Specification Sheet for 106.7 m. Span Open Web Girder (Welded through type) 25 T Loading – 2008

Name and address of Fabricator		:	M/s. Royal Infraconstru Ltd., Urta Industrial Growth Centre, Raipur – 493221 (C.G.)
Welding Procedure specification No.		:	ROYAL/SIVOK-RANGPO/106.7/27 dated 5/8/2022
01.	Drawing No.	:	RDSO/B-17185/R (G.A.)
02.	Welding Joint Description.	:	Fillet 12mm
03.	Base Metal.	:	IS: 2062:2011 E-350 C.
04.	Welding Process	:	GMAW
05.	Welding Position.	:	Horizontal
06.	Welding Consumable.	:	
6.1	Electrode/Wire	Class	: I of IRS M 46-2013.
		Type	: Copper coated Solid Wire.
		Drying Method	: N.A.
6.2	Flux		
		Class	: N.A.
		Type	: N.A.
		Drying Method	: N.A.
6.3	Shielding Gas	:	CO2
07.	Base Metal Preparation	:	Fusion Faces and adjacent surfaces are cleaned and made free from Cracks, Notches, Mill scale, Grease, Paint, Rust etc., which may affected weld quality.
7.1	Joint design Details	:	
	(Sketch showing arrangements of parts, weld beat weld passes & their sequence etc.,) Component :- End Bracket web with flange V type groove to be fill up by weld material in both plate.		<p>12</p> <p>10</p> <p>12</p> <p>20</p> <p>12 MM WELD</p> <p>12</p> <p>20</p> <p>12 MM WELD</p> <p>STRINGER</p>
7.2	Joint preparation	:	As Per IS: 10178 – 1995, CL9, IRS B1-2001, CI.17.3 & WBC – 2001.
08.	Welding Current	:	
		Type	: DC
		Polarity	: Reverse
09.	Welder qualification	:	As per IS: 7310/7307 (Part-I) – 1974
10.	Welding Parameters and technique	:	
10.1	Welding Parameters	:	


ROYAL-IFL (JV)

Weld Sequence No.	Electrodes wire dia. (mm)	Current (Amps)	Arc Voltage (Volt)	Wire Feed Speed (m/min)	Travel Speed (m/min)	Electrical Stick out (mm)	Gas Flow (l/min.)
1	1.2	180 - 220	24 - 28	1.4 - 2.2	N.A.	13 - 18	15 - 20
2	1.2	200 - 220	24 - 28	1.6 - 2.4	N.A.	13 - 18	15 - 20
3	1.2	180 - 220	24 - 28	1.4 - 2.2	N.A.	13 - 18	15 - 20

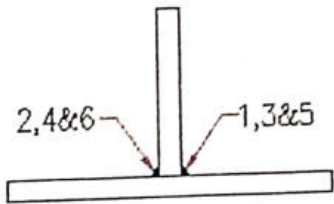
10.2	Welding Sequence and technique	:	
			

11.	Provision of run-on / run-off tabs	:	N.A.
12.	Cleaning of weld bead before laying next weld bead	:	Yes
13.	Root preparation before welding other side of groove weld	:	N.A.
14.	Preheating and inter pass temperature	:	N.A. 110°C - 150°C
15.	Peening	:	N.A.
16.	Post Weld treatment	:	N.A.
17.	Rectification of weld defect	:	By re-welding after complete removal of defective weld & rectify the weld as per CI.32.2 of IS 9595-96, using B1 class of Electrodes of specn. IRS M.28-2017 after conducting DP Test.
18.	Inspection of Weld	:	Visual & D.P. Test.
19.	Any other relevant Details	:	End Bracket web with flange

Welding Procedure Specification Sheet for 106.7 m. Span Open Web Girder (Welded through type) 25 T Loading – 2008

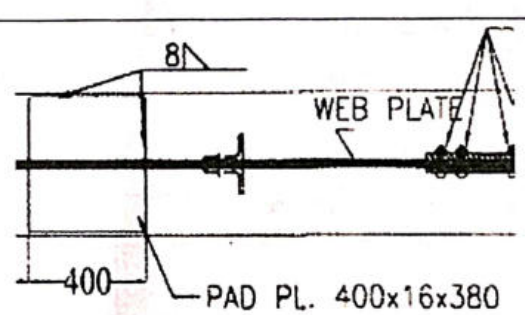Name and address of Fabricator		:	M/s. Royal Infraconstru Ltd., Urli Industrial Growth Centre, Raipur – 493221 (C.G.)
Welding Procedure specification No.		:	ROYAL/SIVOK-RANGPO/106.7/28 dated 5/8/2022
01.	Drawing No.	:	RDSO/B-17185/R (G.A.)
02.	Welding Joint Description.	:	Fillet 8 mm
03.	Base Metal.	:	IS: 2062:2011 E-350 C.
04.	Welding Process	:	GMAW
05.	Welding Position.	:	Horizontal
06.	Welding Consumable.	:	
6.1	Electrode/Wire	Class :	I of IRS M 46-2013.
		Type :	Copper coated Solid Wire.
		Drying Method :	N.A.
6.2	Flux		
		Class :	N.A.
		Type :	N.A.
		Drying Method :	N.A.
6.3	Shielding Gas	:	CO2
07.	Base Metal Preparation	:	Fusion Faces and adjacent surfaces are cleaned and made free from Cracks, Notches, Mill scale, Grease, Paint, Rust etc., which may affected weld quality.
7.1	Joint design Details	:	
	(Sketch showing arrangements of parts, weld beat weld passes & their sequence etc.,) Component :- Pad Plate girder with Bottom Flange of End Cross		
7.2	Joint preparation	:	As Per IS: 10178 – 1995, CL.9, IRS B1-2001, CI.17.3 & WBC – 2001.
08.	Welding Current	:	
		Type :	DC
		Polarity :	Reverse
09.	Welder qualification	:	As per IS: 7310/7307 (Part-I) – 1974
10.	Welding Parameters and technique	:	
10.1	Welding Parameters	:	


Weld Sequence No.	Electrodes wire dia. (mm)	Current (Amps)	Arc Voltage (Volt)	Wire Feed Speed (m/min)	Travel Speed (m/min)	Electrical Stick out (mm)	Gas Flow (l/min.)
1	1.2	180 - 220	24 - 28	1.4 - 2.2	N.A.	13 - 18	15 - 20
2	1.2	180 - 220	24 - 28	1.4 - 2.2	N.A.	13 - 18	15 - 20

10.2	Welding Sequence and technique	:	
			

11.	Provision of run-on / run-off tabs	:	N.A.
12.	Cleaning of weld bead before laying next weld bead	:	By brush cleaning & grinding
13.	Root preparation before welding other side of groove weld	:	N.A.
14.	Preheating and inter pass temperature	:	N.A. 110°C - 150°C
15.	Peening	:	N.A.
16.	Post Weld treatment	:	N.A.
17.	Rectification of weld defect	:	By re-welding after complete removal of defective weld & rectify the weld as per CI.32.2 of IS 9595-96, using B1 class of Electrodes of specn. IRS M.28-2017 after conducting DP Test.
18.	Inspection of Weld	:	Visual & D.P. Test.
19.	Any other relevant Details	:	Pad Plate of End Cross Girder


232

Welding Procedure Specification Sheet for 106.7 m. Span Open Web Girder (Welded through type) 25 T Loading – 2008

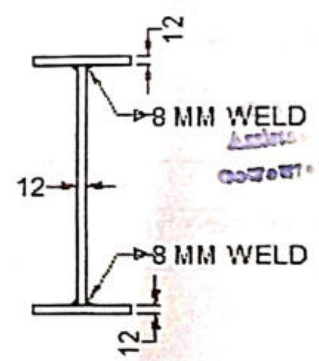Name and address of Fabricator		:	M/s. Royal Infraconstru Ltd., Uda Industrial Growth Centre, Raipur – 493221 (C.G.)
Welding Procedure specification No.		:	ROYAL/SIVOK-RANGPO/106.7/29 dated 5/8/2022
01.	Drawing No.	:	RDSO/B-17185/R (G.A.)
02.	Welding Joint Description.	:	Fillet 8 mm
03.	Base Metal.	:	IS: 2062:2011 E-350 C.
04.	Welding Process	:	GMAW
05.	Welding Position.	:	Horizontal
06.	Welding Consumable.	:	
6.1	Electrode/Wire	Class :	I of IRS M 46-2013.
		Type :	Copper coated Solid Wire.
		Drying Method :	N.A.
6.2	Flux	Class :	N.A.
		Type :	N.A.
		Drying Method :	N.A.
6.3	Shielding Gas	:	CO2
07.	Base Metal Preparation	:	Fusion Faces and adjacent surfaces are cleaned and made free from Cracks, Notches, Mill scale, Grease, Paint, Rust etc., which may affected weld quality.
7.1	Joint design Details	:	
	(Sketch showing arrangements of parts, weld bead weld passes & their sequence etc.,) Component :- End Diaphragm of L0 Joint.		
7.2	Joint preparation	:	As Per IS: 10178 – 1995, CL9, IRS B1-2001, CI.17.3 & WBC – 2001.
08.	Welding Current	:	
		Type :	DC
		Polarity :	Reverse
09.	Welder qualification	:	As per IS: 7310/7307 (Part-I) – 1974
10.	Welding Parameters and technique	:	
10.1	Welding Parameters	:	

ROYAL - IJTL (JV)

Weld Sequence No.	Electrodes wire dia. (mm)	Current (Amps)	Arc Voltage (Volt)	Wire Feed Speed (m/min)	Travel Speed (m/min)	Electrical Stick out (mm)	Gas Flow (l/min.)
1	1.2	180 - 220	24 - 28	1.4 - 2.2	N.A.	13 - 18	15 - 20
2	1.2	180 - 220	24 - 28	1.4 - 2.2	N.A.	13 - 18	15 - 20

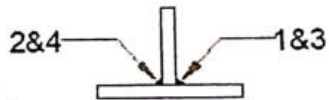10.2	Welding Sequence and technique	:	
			

11.	Provision of run-on / run-off tabs	:	N.A.
12.	Cleaning of weld bead before laying next weld bead	:	By brush cleaning & grinding
13.	Root preparation before welding other side of groove weld	:	N.A.
14.	Preheating and inter pass temperature	:	N.A. 110°C - 150°C
15.	Peening	:	N.A.
16.	Post Weld treatment	:	N.A.
17.	Rectification of weld defect	:	By re-welding after complete removal of defective weld & rectify the weld as per CI.32.2 of IS 9595-96, using B1 class of Electrodes of specn. IRS M.28-2017 after conducting DP Test.
18.	Inspection of Weld	:	Visual & D.P. Test.
19.	Any other relevant Details	:	End Diaphragm

233

Appendix-V (Ref.CI.26 of B I-2001).

Welding Procedure Specification Sheet for 106.7 m. Span Open Web Girder (Welded through type) 25 T Loading – 2008

Name and address of Fabricator		:	M/s. Royal Infraconstru Ltd. Urla Industrial Growth Centre, Raipur – 492003 (C.G.)
Welding Procedure specification No.		:	ROYAL/SIVOK-RANGPO/106.7/30 dated 5/8/2022
01.	RDSO Drawing No.	:	RDSO/B-17185/R (G.A.)
02.	Welding Joint Description.	:	Fillet 5 mm Tack Weld
03.	Base Metal.	:	IS: 2062:2011 E-350 C.
04.	Welding Process	:	GMAW (GMAW machine with CO2 Gas Cylinder.)
05.	Welding Position.	:	Horizontal / Vertical
06.	Welding Consumable.	:	
6.1	Electrode/Wire	Class :	I of IRS M 46-2013.
		Type :	Copper coated Solid Wire.
		Drying Method :	N.A.
6.2	Flux	Class :	N.A.
		Type :	N.A.
		Drying Method :	N.A.
6.3	Shielding Gas	:	CO ₂
07.	Base Metal Preparation	:	Fusion Faces and adjacent surfaces are cleaned and made free from Cracks, Notches, Mill scale, Grease, Paint, Rust etc., which may affected weld quality.
7.1	Joint design Details	:	
	(Sketch showing arrangements of parts, weld bead details, weld passes & their sequence etc.,)		Length of tack Weld 50mm Gap between two tack Weld appr.300mm Weld Size-5 mm
7.2	Joint preparation	:	As Per IS: 10178 – 1995, CL.9, IRS B1-2001, CI.17.3 & WBC – 2001.
08.	Welding Current	:	
		Type :	DC
		Polarity :	Reverse
09.	Welder qualification	:	As per IS: 7310 /7307 (Part-I) – 1974
10.	Welding Parameters and technique	:	
10.1	Welding Parameters	:	

Appendix-V (Ref.CI.26 of BI-2001)


Weld Pass No.	Electrodes wire dia. (mm)	Current (Amps)	Arc Voltage (Volt)	Wire Feed Speed (m/min)	Travel Speed (m/min)	Electrical Stick out (mm)	Gas Flow (l/min.)
1	1.2	180 – 200	24 – 26	1.6 – 2.0	N.A.	13 – 16	16-18

10.2	Welding Sequence and technique	:	
			Length of tack Weld 50mm Gap between two tack Weld appr.300mm Weld Size-5 mm

11.	Provision of run-on / run-off tabs	:	N.A.
12.	Cleaning of weld bead before laying next weld bead	:	N.A.
13.	Root preparation before welding other side of groove weld	:	N.A.
14.	Preheating and inter pass temperature	:	N.A. 110°C - 150°C
15.	Peening	:	N.A.
16.	Post Weld treatment	:	N.A.
17.	Rectification of weld defect	:	By re-welding after complete removal of defective weld.
18.	Inspection of Weld	:	Visual & D.P.Test.
19.	Any other relevant Details	:	Tack welds of all welded components.


Railway Open Web Girder (25t loading)
30.5 m clear span (under slung)
MODEL WPSS No- RDSO/ Infra-II/ B&S/ RG/
OWG./ WPSS / 30.5 US series (12 nos)

Welding Procedure Specification Sheet for 30.5 Mtr. (Underslung) Open Web Girder

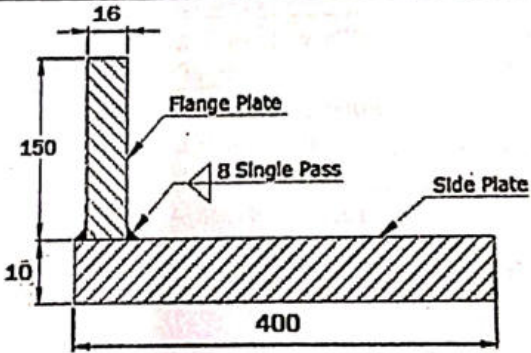Name and address of Signature of PEC		:	M/s. PRECISION ENGINEERING CORPORATION, Plot No.- 139-C&F, Light Industrial Area, Dhillai - 490026 (C.G.)
Welding Procedure specification No.		:	PEC/RVNL-PUNE/US(30.5)/WPSS/01
Drawing No.		:	RDSO/B-17146 # Top Chord Flange & Side Plate on Section A-A
Welding Joint Description.		:	Fillet
Base Metal.		:	IS: 2062 - 2011 Gr. E250 BO
Welding Process		:	S.A.W
Welding Position.		:	Flat
Welding Consumable.		:	
Electrode/Wire			
	Class	:	W1 of IRS M:39-2001
	Type	:	Copper Coated Mild Steel Wire
	Drying Method	:	N.A.
Flux			
	Class	:	F1 of IRS M:39 - 2001
	Type	:	Agglomerated
	Drying Method	:	As recommended by Manufacturer
Shielding Gas		:	N.A.
Base Metal Preparation		:	Material to be cut straight & square by controlled gas cutting. Fusion faces and adjacent surfaces are cleaned and made free from Cracks Notches, Mill Scale, Grease Paint, Rust etc. which may affect Weld Quality.
Joint design Details		:	Part sketch shown.
(Sketch showing arrangements of parts, weld groove details, weld passes & their sequence etc.)			 <p>Flange Plate 16mm to Side Plate Thk. 10mm of Top Chord</p>
Joint preparation		:	As Per IRS B1-2001 Cl. 17.3, IRS WBC-2001, IS 4353-1995 Cl.7
Welding Current		:	
	Type	:	DC
	Polarity	:	Reverse
Welder qualification		:	As per IS: 7310 (Part 1) 1974, & IS 7307


[Handwritten signature]
28-11-19

Welding Parameters and technique:							
J e No.	Welding Parameters						
	Electrodes wire dia. (mm)	Current (Amps)	Arc Voltage (Volt)	Wire Feed Speed (m/min)	Travel Speed (m/min)	Electrode Stick out (mm)	Gas Flow (L/min.)
mm)	4.00	450-500	25-29	1.0-1.2	0.45-0.50	15-20	N.A.

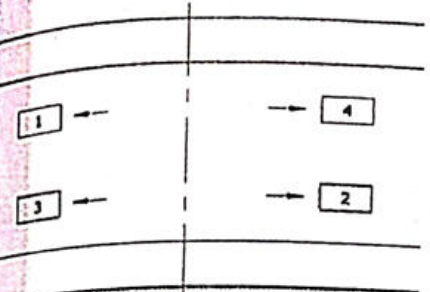Welding Sequence and technique		:
		Welding from Run – on – off tabs

Provision of run-on / run-off tabs	:	Yes
Cleaning of weld bead before laying next weld bead	:	N.A.
Root preparation before welding other side of groove weld	:	N.A.
Preheating and inter pass temperature	:	N.A.
Peening	:	Not Required
Post Weld treatment	:	Not Required
Rectification of weld defect	:	By re-welding after complete removal of defect by grinding as per IS 9595-96 Cl. 32.2, using A2 Class of electrodes of Specn. IRS M.28-02, after conducting D.P. Test.
Inspection of Weld	:	Visual, D.P. Test & Macro Etching.
Any other relevant Details with acceptance level	:	IRS-B1, IRC-24, IS-7307, IS-7310, IS-9595, IS 816

Welding Procedure Specification Sheet for 30.5 Mtr. (Underslung) Open Web Girder

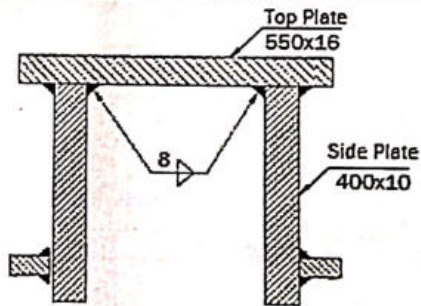Address of Signature of PEC		:	M/s. PRECISION ENGINEERING CORPORATION. Plot No.- 139-C&F, Light Industrial Area, Bhilal - 490026 (C.G.)
Procedure specification No.		:	PEC/RVNL-PUNE/US(30.5)/WPSS/02
Welding No.		:	RDSO/B-17146 # Top Chord Top Plate & Side Plate on Section A-A
Welding Joint Description.		:	Fillet
Base Metal.		:	IS: 2062 - 2011 Gr. E250 BO
Welding Process		:	S.A.W
Welding Position.		:	Flat
Welding Consumable.		:	
Electrode/Wire		:	
Class		:	W1 of IRS M:39-2001
Type		:	Copper Coated Mild Steel Wire
Drying Method		:	N.A.
Class		:	F1 of IRS M:39 - 2001
Type		:	Agglomerated
Drying Method		:	As recommended by Manufacturer
Shielding Gas		:	N.A.
Base Metal Preparation		:	Material to be cut straight & square by controlled gas cutting. Fusion faces and adjacent surfaces are cleaned and made free from Cracks Notches, Mill Scale, Grease Paint, Rust etc. which may affect Weld Quality.
Joint design Details		:	Part sketch shown.
(Sketch showing arrangements of parts, weld groove details, weld passes & their sequence etc.)		:	 <p>Top Plate Thk. 16 mm to Side Plate 10 of Top Chord</p>
Joint preparation		:	As Per IRS B1-2001 Cl. 17.3, IRS WBC-2001, IS 4353-1995 Cl.7
Welding Current		:	
Type		:	DC
Polarity		:	Reverse
Welder qualification		:	As per IS: 7310 (Part 1) 1974, & IS 7307

Welding Parameters and technique:							
Welding Parameters							
Electrodes wire dia. (mm)	Current (Amps)	Arc Voltage (Volt)	Wire Feed Speed (m/min)	Travel Speed (m/min)	Electrode Stick out (mm)	Gas Flow (L/min.)	
4.00	450-500	25-29	1.0-1.2	0.45-0.50	15-20	N.A.	


Welding Sequence and technique		:
		Welding from Run – on – off tabs

Provision of run-on / run-off tabs	:	Yes
Cleaning of weld bead before laying next weld bead	:	N.A.
Root preparation before welding other side of groove weld	:	N.A.
Preheating and inter pass temperature	:	N.A.
Peening	:	Not Required
Post Weld treatment	:	Not Required
Rectification of weld defect	:	By re-welding after complete removal of defect by grinding as per IS 9595-96 Cl. 32.2, using A2 Class of electrodes of Specn. IRS M.28-02, after conducting D.P. Test.
Inspection of Weld	:	Visual, D.P. Test & Macro Etching.
Any other relevant Details with acceptance level	:	IRS-B1 , IRC-24,IS-7307,IS-7310,IS-9595,IS 816

41/14


Page 5

Welding Procedure Specification Sheet for 30.5 Mtr. (Underslung) Open Web Girder

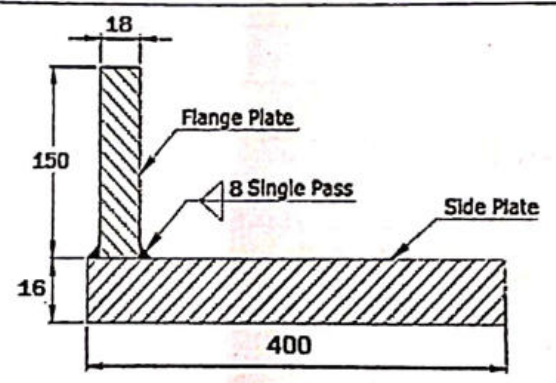Name and address of Signature of PEC		:	M/s. PRECISION ENGINEERING CORPORATION. Plot No.- 139-C&F, Light Industrial Area, Bhilal - 490026 (C.G.)
Welding Procedure specification No.		:	PEC/RVNL-PUNE/US(30.5)/WPSS/03
Drawing No.		:	RDSO/B-17146 # Top Chord Flange & Side Plate on Section B-B & C-C
Welding Joint Description.		:	Fillet
Base Metal.		:	IS: 2062 - 2011 Gr. E250 BO
Welding Process		:	S.A.W
Welding Position.		:	Flat
Welding Consumable.		:	
Electrode/Wire		:	
Class		:	W1 of IRS M:39-2001
Type		:	Copper Coated Mild Steel Wire
Drying Method		:	N.A.
Flux		:	
Class		:	F1 of IRS M:39 - 2001
Type		:	Agglomerated
Drying Method		:	As recommended by Manufacturer
Shielding Gas		:	N.A.
Base Metal Preparation		:	Material to be cut straight & square by controlled gas cutting. Fusion faces and adjacent surfaces are cleaned and made free from Cracks Notches, Mill Scale, Grease Paint, Rust etc. which may affect Weld Quality.
Joint design Details		:	Part sketch shown.
(Sketch showing arrangements of parts, weld groove details, weld passes & their sequence etc.)		:	 <p>Flange Plate 18mm to Side Plate Thk. 16mm of Top Chord</p>
Joint preparation		:	As Per IRS B1-2001 Cl. 17.3, IRS WBC-2001, IS 4353-1995 Cl.7
Welding Current		:	
Type		:	DC
Polarity		:	Reverse
Welder qualification		:	As per IS: 7310 (Part 1) 1974, & IS 7307


41/15

Welding Parameters and technique:							
Weld Sequence No.	Welding Parameters				Travel Speed (m/min)	Electrode Stick out (mm)	Gas Flow (L/min.)
	Electrodes wire dia. (mm)	Current (Amps)	Arc Voltage (Volt)	Wire Feed Speed (m/min)			
4 (Snm)	4.00	450-500	25-29	1.0-1.2	0.45-0.50	15-20	N.A.

Welding Sequence and technique		:
		Welding from Run – on – off tabs


Provision of run-on / run-off tabs	:	Yes
Cleaning of weld bead before laying next weld bead	:	N.A.
Root preparation before welding other side of groove weld	:	N.A.
Preheating and inter pass temperature	:	N.A.
Peening	:	Not Required
Post Weld treatment	:	Not Required
Rectification of weld defect	:	By re-welding after complete removal of defect by grinding as per IS 9595-96 Cl. 32.2, using A2 Class of electrodes of Specn. IRS M.28-02, after conducting D.P. Test.
Inspection of Weld	:	Visual, D.P. Test & Macro Etching.
Any other relevant Details with acceptance level	:	IRS-B1 , IRC-24, IS-7307, IS-7310, IS-9595, IS 816

Welding Procedure Specification Sheet for 30.5 Mtr. (Underslung) Open Web Girder

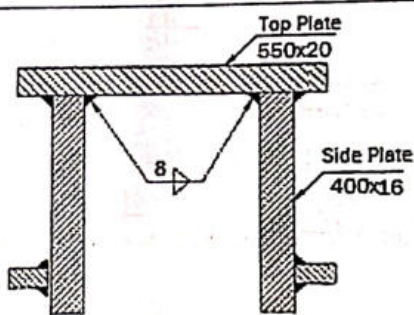Name and address of Signature of PEC		:	M/s. PRECISION ENGINEERING CORPORATION. Plot No.- 139-C&F, Light Industrial Area, Bhilai - 490026 (C.G.)
Welding Procedure specification No.		:	PEC/RVNL-PUNE/US(30.5)/WPSS/04
Drawing No.		:	RDSO/B-17146 # Top Chord Top Plate & Side Plate on Section B-B & C-C
Welding Joint Description.		:	Fillet
Base Metal.		:	IS: 2062 - 2011 Gr. E250 BO
Welding Process		:	S.A.W
Welding Position.		:	Flat
Welding Consumable.		:	
Electrode/Wire			
	Class	:	W1 of IRS M:39-2001
	Type	:	Copper Coated Mild Steel Wire
	Drying Method	:	N.A.
Flux			
	Class	:	F1 of IRS M:39 - 2001
	Type	:	Agglomerated
	Drying Method	:	As recommended by Manufacturer
Shielding Gas		:	N.A.
Base Metal Preparation		:	Material to be cut straight & square by controlled gas cutting. Fusion faces and adjacent surfaces are cleaned and made free from Cracks Notches, Mill Scale, Grease Paint, Rust etc. which may affect Weld Quality.
Joint design Details		:	Part sketch shown.
(Sketch showing arrangements of parts, weld groove details, weld passes & their sequence etc.)		 <p>Top Plate Thk. 20 mm to Side Plate 16 of Top Chord</p>	
Joint preparation		:	As Per IRS B1-2001 Cl. 17.3, IRS WBC-2001, IS 4353-1995 Cl.7
Welding Current		:	
	Type	:	DC
	Polarity	:	Reverse
Welder qualification		:	As per IS: 7310 (Part 1) 1974, & IS 7307

Welding Parameters and technique:							
Weld Sequence No.	Welding Parameters						
	Electrodes wire dia. (mm)	Current (Amps)	Arc Voltage (Volt)	Wire Feed Speed (m/min)	Travel Speed (m/min)	Electrode Stick out (mm)	Gas Flow (L/min.)
1 - 4 (Smm)	4.00	450-500	25-29	1.0-1.2	0.45-0.50	15-20	N.A.

0.2 Welding Sequence and technique

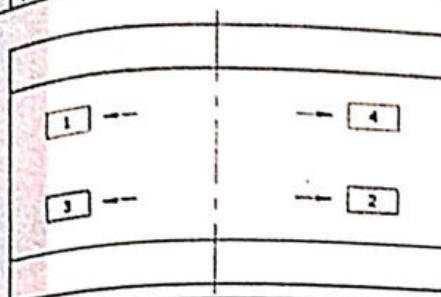


Welding from Run - on - off tabs

1.	Provision of run-on / run-off tabs	:	Yes
2.	Cleaning of weld bead before laying next weld bead	:	N.A.
3.	Root preparation before welding other side of groove weld	:	N.A.
4.	Preheating and inter pass temperature	:	N.A.
5.	Peening	:	Not Required
6.	Post Weld treatment	:	Not Required
7.	Rectification of weld defect	:	By re-welding after complete removal of defect by grinding as per IS 9595-96 Cl. 32.2, using A2 Class of electrodes of Specn. IRS M.28-02, after conducting D.P. Test.
8.	Inspection of Weld	:	Visual, D.P. Test & Macro Etching.
9.	Any other relevant Details with acceptance level	:	IRS-B1, IRC-24, IS-7307, IS-7310, IS-9595, IS 816


41/18

Page 9

Welding Procedure Specification Sheet for 30.5 Mtr. (Underslung) Open Web Girder

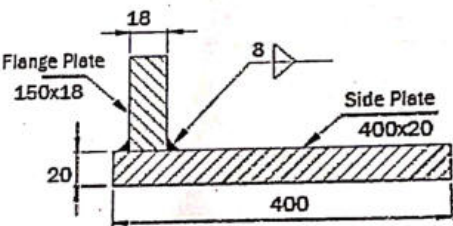
Signature and address of Signature of PEC	:	M/s. PRECISION ENGINEERING CORPORATION, Plot No.- 139-C&F, Light Industrial Area, Bhilal - 490026 (C.G.)
Welding Procedure specification No.	:	PEC/RVNL-PUNE/US(30.5)/WPSS/05
Drawing No.	:	RDSO/B-17145 # Bottom Chord (L1-L2-L3) Flange Plate to Side Plate on Section A-A
Welding Joint Description.	:	Fillet
Base Metal.	:	IS: 2062 - 2011 Gr. E250 BO
Welding Process	:	S.A.W
Welding Position.	:	Flat
Welding Consumable.	:	
Electrode/Wire	Class :	W1 of IRS M:39-2001
	Type :	Copper Coated Mild Steel Wire
	Drying Method :	N.A.
Flux		
	Class :	F1 of IRS M:39 - 2001
	Type :	Agglomerated
	Drying Method :	As recommended by Manufacturer
Shielding Gas	:	N.A.
Base Metal Preparation	:	Material to be cut straight & square by controlled gas cutting. Fusion faces and adjacent surfaces are cleaned and made free from Cracks Notches, Mill Scale, Grease Paint, Rust etc. which may affect Weld Quality.
Joint design Details	:	Part sketch shown.
(Sketch showing arrangements of parts, weld groove details, weld passes & their sequence etc.)		 <p>Flange Plate Thk. 18 mm to Side Plate 20 of Bottom Chord L1-L2-L3</p>
Joint preparation	:	As Per IRS B1-2001, Cl. 17.3, IRS WBC-2001, IS 10178 -1995 Cl.9
Welding Current	:	
	Type :	DC
	Polarity :	Reverse
Welder qualification	:	As per IS: 7310 (Part 1) 1974& IS 7307

Welding Parameters and technique:							
Weld Sequence No.	Welding Parameters						
	Electrode/ wire dia. (mm)	Current (Amps)	Arc Voltage (Volt)	Wire Feed Speed (m/min)	Travel Speed (m/min)	Electrode Stick out (mm)	Gas Flow (L/min.)
8 (8mm)	4.00	450-500	25-29	1.0-1.2	0.45-0.50	15-20	N.A.

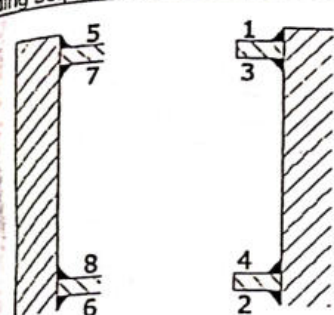Welding Sequence and technique		:
		Welding from Run – on – off tabs

1.	Provision of run-on / run-off tabs	:	N.A.
2.	Cleaning of weld bead before laying next weld bead	:	N.A.
3.	Root preparation before welding other side of groove weld	:	N.A.
4.	Preheating and inter pass temperature	:	N.A.
5.	Peening	:	Not Required
6.	Post Weld treatment	:	Not Required
7.	Rectification of weld defect	:	By re-welding after complete removal of defect by grinding as per IS 9595-96 Cl. 32.2, using A2 Class of electrodes of Specn. IRS M.28-02, after conducting D.P. Test.
8.	Inspection of Weld	:	Visual, D.P. Test & Macro Etching.
9.	Any other relevant Details with acceptance level	:	IRS-B1 , IRC-24,IS-7307,IS-7310,IS-9595,IS 816

Welding Procedure Specification Sheet for 30.5 Mtr. (Underslung) Open Web Girder

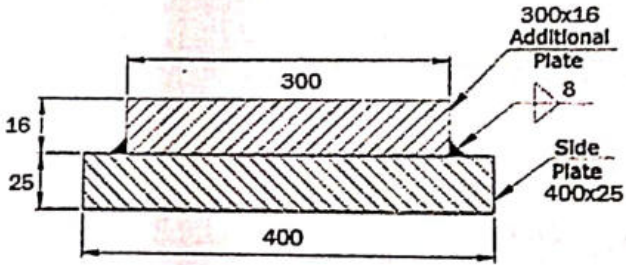Name and address of Signature of PEC		:	M/s. PRECISION ENGINEERING CORPORATION, Plot No.- 139-C&F, Light Industrial Area, Bhilai - 490026 (C.G.)
Welding Procedure specification No.		:	PEC/RVNL-PUNE/US(30.5)/WPSS/06
Drawing No.		:	RDSO/B-17145 # Bottom Chord (L3-L4-L5) Additional Plate to Side Plate Section B-B
Welding Joint Description.		:	Fillet
Base Metal.		:	IS: 2062 - 2011 Gr. E250 BO
Welding Process		:	S.A.W
Welding Position.		:	Flat
Welding Consumable.		:	
Electrode/Wire		:	
Class		:	W1 of IRS M:39-2001
Type		:	Copper Coated Mild Steel Wire
Drying Method		:	N.A.
Flux		:	
Class		:	F1 of IRS M:39 - 2001
Type		:	Agglomerated
Drying Method		:	As recommended by Manufacturer
Shielding Gas		:	N.A.
Base Metal Preparation		:	Material to be cut straight & square by controlled gas cutting. Fusion faces and adjacent surfaces are cleaned and made free from Cracks Notches, Mill Scale, Grease Paint, Rust etc. which may affect Weld Quality.
Joint design Details		:	Part sketch shown.
(Sketch showing arrangements of parts, weld groove details, weld passes & their sequence etc.)		 <p>Addl. Plate Thk. 16 mm to Side Plate 25mm of Bottom Chord L3-L4-L5</p>	
Joint preparation		:	As Per IRS B1-2001, Cl. 17.3, IRS WBC-2001, IS 10178 -1995 Cl.9
Welding Current		:	
Type		:	DC
Polarity		:	Reverse
Welder qualification		:	As per IS: 7310 (Part 1) 1974& IS 7307

Welding Parameters and technique:							
Weld Sequence No.	Welding Parameters						
	Electrode/wire dia. (mm)	Current (Amps)	Arc Voltage (Volt)	Wire feed Speed (m/min)	Travel Speed (m/min)	Electrode Stick out (mm)	Gas Flow (l/min.)
	4.00	450-500	25-29	1.0-1.2	0.45-0.50	15-20	N.A.


Welding Sequence and technique	
	Welding from Run - on - off tabs

11.	Provision of run-on / run-off tabs	:	N.A.
12.	Cleaning of weld bead before laying next weld bead	:	N.A.
13.	Root preparation before welding other side of groove weld	:	N.A.
14.	Preheating and inter pass temperature	:	N.A.
15.	Peening	:	Not Required
16.	Post Weld treatment	:	Not Required
17.	Rectification of weld defect	:	By re-welding after complete removal of defect by grinding as per IS 9595-96 Cl. 32.2, using A2 Class of electrodes of Specn. IRS M.28-02, after conducting D.P. Test.
18.	Inspection of Weld	:	Visual, D.P. Test & Macro Etching.
19.	Any other relevant Details with acceptance level	:	IRS-B1 , IRC-24,IS-7307,IS-7310,IS-9595,IS 816

41/22

Page 13

Welding Procedure Specification Sheet for 30.5 Mtr. (Underslung) Open Web Girder

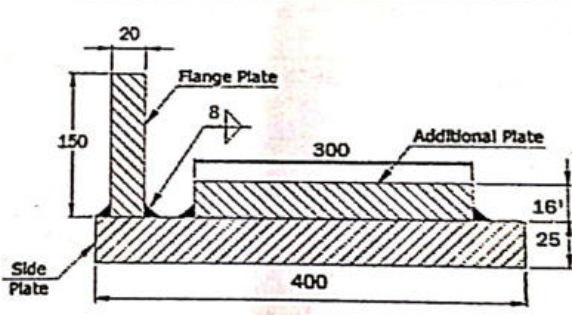Name and address of Signature of PEC		:	M/s. PRECISION ENGINEERING CORPORATION, Plot No.- 139-C&F, Light Industrial Area, Bhilai - 490026 (C.G.)
Welding Procedure specification No.		:	PEC/RVNL-PUNE/US(30.5)/WPSS/07
Drawing No.		:	RDSO/B-17145 # Bottom Chord (L3-L4-L5) Flange Plate to Side Plate Section B-B
Welding Joint Description.		:	Fillet
Base Metal.		:	IS: 2062 - 2011 Gr. E250 B0
Welding Process.		:	S.A.W
Welding Position.		:	Flat
Welding Consumable.		:	
Electrode/Wire			
	Class :	W1 of IRS M:39-2001	
	Type :	Copper Coated Mild Steel Wire	
	Drying Method :	N.A.	
Flux			
	Class :	F1 of IRS M:39 - 2001	
	Type :	Agglomerated	
	Drying Method :	As recommended by Manufacturer	
Shielding Gas		:	N.A.
Base Metal Preparation		:	Material to be cut straight & square by controlled gas cutting. Fusion faces and adjacent surfaces are cleaned and made free from Cracks Notches, Mill Scale, Grease Paint, Rust etc. which may affect Weld Quality.
Joint design Details		:	Part sketch shown.
(Sketch showing arrangements of parts, weld groove details, weld passes & their sequence etc.)		 <p>Flange Plate Thk. 20 mm to Side Plate 25mm of Bottom Chord L3-L4-L5</p>	
Joint preparation		:	As Per IRS 81-2001, Cl. 17.3, IRS WBC-2001, IS 10178 -1995 Cl.9
Welding Current		:	
	Type :	DC	
	Polarity :	Reverse	
Welder qualification		:	As per IS: 7310 (Part 1) 1974& IS 7307

241
41/23


Page 14

Welding Parameters and technique:							
Welding Parameters							
Weld Sequence No.	Electrode/ wire dia. (mm)	Current (Amps)	Arc Voltage (Volt)	Wire Feed Speed (m/min)	Travel Speed (m/min)	Electrode Stick out (mm)	Gas Flow (L/min.)
- 8 (8mm)	4.00	450-500	25-29	1.0-1.2	0.45-0.50	15-20	N.A.

Welding Sequence and technique		
		Welding from Run – on – off tabs


11.	Provision of run-on / run-off tabs	:	N.A.
12.	Cleaning of weld bead before laying next weld bead	:	N.A.
13.	Root preparation before welding other side of groove weld	:	N.A.
14.	Preheating and inter pass temperature	:	N.A.
15.	Peening	:	Not Required
16.	Post Weld treatment	:	Not Required
17.	Rectification of weld defect	:	By re-welding after complete removal of defect by grinding as per IS 9595-96 Cl. 32.2, using A2 Class of electrodes of Specn. IRS M.28-02, after conducting D.P. Test.
18.	Inspection of Weld	:	Visual, D.P. Test & Macro Etching.
19.	Any other relevant Details with acceptance level	:	IRS-B1 , IRC-24,IS-7307,IS-7310,IS-9595,IS 816

Welding Procedure Specification Sheet for 30.5 Mtr. (Underslung) Open Web Girder

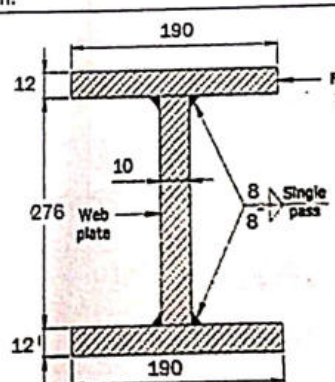Name and address of Signature of PEC		:	M/s. PRECISION ENGINEERING CORPORATION, Plot No.- 139-C&F, Light Industrial Area, Bhilal - 490026 (C.G.)
Drawing No.		:	PEC/RVNL-PUNE/US(30.5)/WPSS/08
Welding Joint Description.		:	RDSO/B-17147 # Verticals Flange Plate to Web Plate
Base Metal.		:	Fillet
Welding Process		:	IS: 2062 - 2011 Gr. E250 B0
Welding Position.		:	S.A.W
Welding Consumable.		:	Flat
Electrode/Wire			
	Class	:	W1 of IRS M:39-2001
	Type	:	Copper Coated Mild Steel Wire
	Drying Method	:	N.A.
Flux			
	Class	:	F1 of IRS M:39 - 2001
	Type	:	Agglomerated
	Drying Method	:	As recommended by Manufacturer
Shielding Gas		:	N.A.
Base Metal Preparation		:	Material to be cut straight & square by controlled gas cutting. Fusion faces and adjacent surfaces are cleaned and made free from Cracks, Notches, Mill Scale, Grease Paint, Rust etc. which may affect Weld Quality.
Joint design Details		:	Part sketch shown.
(Sketch showing arrangements of parts, weld groove details, weld passes & their sequence etc.)			 <p>Flange Plate Thk. 12 mm to Web Plate 10mm of Verticals</p>
Joint preparation		:	As Per IRS B1-2001, Cl. 17.3, IRS WBC-2001, IS 10178 -1995 Cl.9
Welding Current		:	
	Type	:	DC
	Polarity	:	Reverse
Welder qualification		:	As per IS: 7310 (Part 1) 1974& IS 7307

242
41/25

Welding Parameters and technique:							
Weld Sequence No.	Welding Parameters						
	Electrode/wire dia. (mm)	Current (Amps)	Arc Voltage (Volt)	Wire Feed Speed (m/min)	Travel Speed (m/min)	Electrode Stick out (mm)	Gas Flow (L/min.)
4 (8mm)	4.00	450-500	25-29	1.0-1.2	0.45-0.50	15-20	N.A.

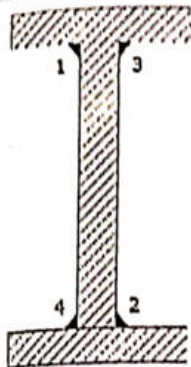
Welding Sequence and technique	
	Welding from Run - on - off tabs

1. Provision of run-on / run-off tabs	:	N.A.
2. Cleaning of weld bead before laying next weld bead	:	N.A.
3. Root preparation before welding other side of groove weld	:	N.A.
4. Preheating and Inter pass temperature	:	N.A.
5. Peening	:	Not Required
6. Post Weld treatment	:	Not Required
7. Rectification of weld defect	:	By re-welding after complete removal of defect by grinding as per IS 9595-96 Cl. 32.2, using A2 Class of electrodes of Specn. IRS M.28-02, after conducting D.P. Test.
8. Inspection of Weld	:	Visual, D.P. Test & Macro Etching.
9. Any other relevant Details with acceptance level	:	IRS-B1, IRC-24, IS-7307, IS-7310, IS-9595, IS 816

4/26


Page 17

Welding Procedure Specification Sheet for 30.5 Mtr. (Underslung) Open Web Girder

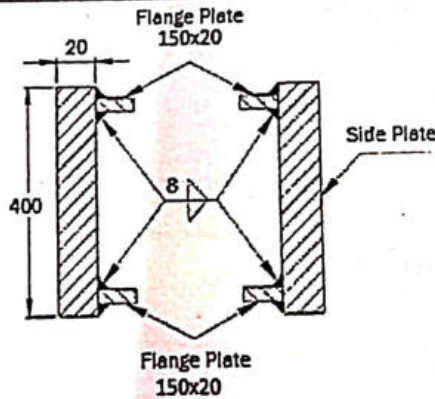Name and address of Signature of PEC		:	M/s. PRECISION ENGINEERING CORPORATION, Plot No.- 139-C&F, Light Industrial Area, Bhilai - 490026 (C.G.)
Welding Procedure specification No.		:	PEC/RVNL-PUNE/US(30.5)/WPSS/09
Drawing No.		:	RDSO/B-17148 # End Raker (U0-L1 & U10-L9) Flange Plate to Side Plate on Section A-A
Welding Joint Description.		:	Fillet
Base Metal.		:	IS: 2062 - 2011 Gr. E250 B0
Welding Process		:	S.A.W
Welding Position.		:	Flat
Welding Consumable.		:	
Electrode/Wire		:	
Class		:	W1 of IRS M:39-2001
Type		:	Copper Coated Mild Steel Wire
Drying Method		:	N.A.
Flux		:	
Class		:	F1 of IRS M:39 - 2001
Type		:	Agglomerated
Drying Method		:	As recommended by Manufacturer
Shielding Gas		:	N.A.
Base Metal Preparation		:	Material to be cut straight & square by controlled gas cutting. Fusion faces and adjacent surfaces are cleaned and made free from Cracks Notches, Mill Scale, Grease Paint, Rust etc. which may affect Weld Quality.
Joint design Details		:	Part sketch shown.
(Sketch showing arrangements of parts, weld groove details, weld passes & their sequence etc.)		 <p>Flange Plate Thk. 20 mm to Side Plate 20 mm of End Raker</p>	
Joint preparation		:	As Per IRS B1-2001, Cl. 17.3, IRS WBC-2001, IS 10178 -1995 Cl.9
Welding Current		:	
Type		:	DC
Polarity		:	Reverse
Welder qualification		:	As per IS: 7310 (Part 1) 1974& IS 7307

41/27 243

Welding Parameters and technique:							
Welding Parameters							
Weld Sequence No.	Electrode/ wire dia. (mm)	Current (Amps)	Arc Voltage (Volt)	Wire Feed Speed (m/min)	Travel Speed (m/min)	Electrode Stick out (mm)	Gas Flow (L/min.)
8 (8mm)	4.00	450-500	25-29	1.0-1.2	0.45-0.50	15-20	N.A.

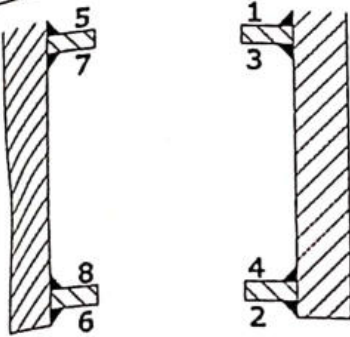
Welding Sequence and technique		:
		Welding from Run - on - off tabs

Provision of run-on / run-off tabs	:	N.A.
Cleaning of weld bead before laying next weld bead	:	N.A.
Root preparation before welding other side of groove weld	:	N.A.
Preheating and inter pass temperature	:	N.A.
Peening	:	Not Required
Post Weld treatment	:	Not Required
Rectification of weld defect	:	By re-welding after complete removal of defect by grinding as per IS 9595-96 Cl. 32.2, using A2 Class of electrodes of Specn. IRS M.28-02, after conducting D.P. Test.
Inspection of Weld	:	Visual, D.P. Test & Macro Etching.
IRS-R1 . IRC-24,IS-7307,IS-7310,IS-9595,IS 816		

41/28

Page 19

Welding Procedure Specification Sheet for 30.5 Mtr. (Underslung) Open Web Girder

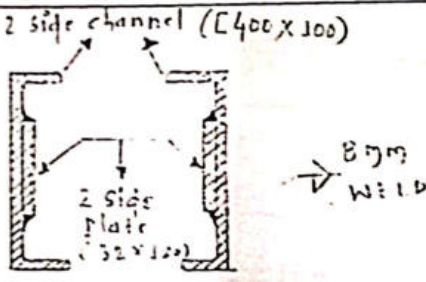Address of Signature of PEC	:	M/s. PRECISION ENGINEERING CORPORATION, Plot No.- 139-C&F, Light Industrial Area, Bhilai - 490026 (C.G.)
Procedure Specification No.	:	PEC/RVNL-PUNE/US(30.5)/WPSS/10
Drawing No.	:	RDSO/B-17149 # Diagonal (U2-L3 & U8-L7) Channel to Side Plate on Section B-B
Welding Joint Description.	:	Fillet
Base Metal	:	IS: 2062 - 2011 Gr. E250 B0
Welding Process	:	S.A.W
Welding Position	:	Flat
Welding Consumable	:	
Electrode/Wire	:	
	Class :	W1 of IRS M:39-2001
	Type :	Copper Coated Mild Steel Wire
	Drying Method :	N.A.
Flux	:	
	Class :	F1 of IRS M:39 - 2001
	Type :	Agglomerated
	Drying Method :	As recommended by Manufacturer
Shielding Gas	:	N.A.
Base Metal Preparation	:	Material to be cut straight & square by controlled gas cutting. Fusion faces and adjacent surfaces are cleaned and made free from Cracks Notches, Mill Scale, Grease Paint, Rust etc. which may affect Weld Quality.
Joint design Details	:	Part sketch shown.
Sketch showing arrangements of parts, weld groove details, weld passes & their sequence etc.)		 <p>Side Channel (400x100) mm to Side Plate 32 mm of Diagonal</p>
Joint preparation	:	As Per IRS B1-2001, Cl. 17.3, IRS WBC-2001, IS 10178 -1995 Cl.9
Welding Current	:	
	Type :	DC
	Polarity :	Reverse
Welder qualification	:	As per IS: 7310 (Part 1) 1974& IS 7307

41/23 244
Page 20

Welding Parameters and technique:							
Welding Parameters							
Weld ence No.	Electrode/ wire dia. (mm)	Current (Amps)	Arc Voltage (Volt)	Wire Feed Speed (m/min)	Travel Speed (m/min)	Electrode Stick out (mm)	Gas Flow (L/min.)
B (8mm)	4.00	450-500	25-29	1.0-1.2	0.45-0.50	15-20	N.A.


Welding Sequence and technique	:
	Welding from Run – on – off tabs

Provision of run-on / run-off tabs	:	N.A.
Cleaning of weld bead before laying next weld bead	:	N.A.
Root preparation before welding other side of groove weld	:	N.A.
Preheating and inter pass temperature	:	N.A.
Peening	:	Not Required
Post Weld treatment	:	Not Required
Rectification of weld defect	:	By re-welding after complete removal of defect by grinding as per IS 9595-96 Cl. 32.2, using A2 Class of electrodes of Specn. IRS M.28-02, after conducting D.P. Test.
Inspection of Weld	:	Visual, D.P. Test & Macro Etching.
IS-81 IS-24 IS-7307 IS-7310 IS-9595, IS 816		

41/30

Page 21

Welding Procedure Specification Sheet for 30.5 Mtr. (Underslung) Open Web Girder

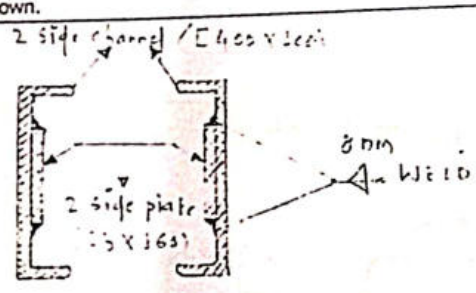Signature and address of Signature of PEC	:	M/s. PRECISION ENGINEERING CORPORATION, Plot No.- 139-C&F, Light Industrial Area, Bhilai - 490026 (C.G.)
Procedure specification No.	:	PEC/RVNL-PUNE/US(30.5)/WPSS/11
Drawing No.	:	RDSO/B-17149/1 # Diagonal (U4-L3 & U6-L7) & (U4-L5 & U6-L5)
Welding Joint Description.	:	Channel to Side Plate on Section C-C & D-D
Base Metal.	:	Fillet
Welding Process	:	IS: 2062 - 2011 Gr. E250 B0
Welding Position.	:	S.A.W
Welding Consumable.	:	Flat
Electrode/Wire		
	Class :	W1 of IRS M:39-2001
	Type :	Copper Coated Mild Steel Wire
	Drying Method :	N.A.
Flux		
	Class :	F1 of IRS M:39 - 2001
	Type :	Agglomerated
	Drying Method :	As recommended by Manufacturer
Shielding Gas	:	N.A.
Base Metal Preparation	:	Material to be cut straight & square by controlled gas cutting. Fusion faces and adjacent surfaces are cleaned and made free from Cracks, Notches, Mill Scale, Grease Paint, Rust etc. which may affect Weld Quality.
Joint design Details	:	Part sketch shown.
(Sketch showing arrangements of parts, weld groove details, weld passes & their sequence etc.)		 <p>Side Channel (400x100) mm to Side Plate 25 mm of Diagonal</p>
Joint preparation	:	As Per IRS B1-2001, Cl. 17.3, IRS WBC-2001, IS 10178 -1995 Cl.9
Welding Current	:	
	Type :	DC
	Polarity :	Reverse
Welder qualification	:	As per IS: 7310 (Part 1) 1974& IS 7307

41/31245

Page 22

Welding Parameters and technique:							
Welding Parameters							
Weld Sequence No.	Electrode/ wire dia. (mm)	Current (Amps)	Arc Voltage (Volt)	Wire Feed Speed (m/min)	Travel Speed (m/min)	Electrode Stick out (mm)	Gas Flow (L/min.)
1.8 (Smm)	4.00	450-500	25-29	1.0-1.2	0.45-0.50	15-20	N.A.
2 / Welding Sequence and technique							
				Welding from Run – on – off tabs			
1.	Provision of run-on / run-off tabs		:	N.A.			
2.	Cleaning of weld bead before laying next weld bead		:	N.A.			
3.	Root preparation before welding other side of groove weld		:	N.A.			
4.	Preheating and inter pass temperature		:	N.A.			
5.	Peening		:	Not Required			
6.	Post Weld treatment		:	Not Required			
7.	Rectification of weld defect		:	By re-welding after complete removal of defect by grinding as per IS 9595-96 Cl. 32.2, using A2 Class of electrodes of Specn. IRS M.28-02, after conducting D.P. Test.			
8.	Inspection of Weld		:	Visual, D.P. Test & Macro Etching.			
Any other relevant Details with acceptance level			:	IRS-B1, IRC-24, IS-7307, IS-7310, IS-9595, IS 816			

Welding Procedure Specification Sheet for 30.5 Mtr. (Underslung) Open Web Girder

Name and address of Signature of PEC		: M/s. PRECISION ENGINEERING CORPORATION, Plot No.- 139-C&F, Light Industrial Area, Bhilal - 490026 (C.G.)					
Drawing No.		: PEC/RVNL-PUNE/US(30.5)/WPSS/12					
Welding Joint Description.		: RDSO/B-17141 (Series) # All Components, Where required					
Base Metal.		: 5mm Tack Weld on all fillet joints					
Welding Process		: IS: 2062 - 2011 Gr. E250 B0					
Welding Position.		: M.M.A.W.					
Welding Consumable.		: Horizontal - Vertical					
Electrode/Wire		: A3 of IRS M:28-2008 with Amendment 1 of 2003					
Class		: Rutile Coating					
Type		: N.A.					
Drying Method		: N.A.					
Flux		: N.A.					
Class		: N.A.					
Type		: N.A.					
Drying Method		: N.A.					
Shielding Gas		: N.A.					
Base Metal Preparation		: Material to be cut straight & square by controlled gas cutting. Fusion faces and adjacent surfaces are cleaned and made free from Cracks Notches, Mill Scale, Grease Paint, Rust etc. which may affect Weld Quality.					
Joint design Details		: N.A.					
Joint preparation		: As Per IRS B1-2001 Cl. 17.3, IRS WBC-2001, IS 9595-1996 Cl.3					
Welding Current		: DC					
Type		: Reverse					
Polarity		: As per IS: 7310 (Part 1) 1974, & IS 7307					
Welder qualification		: As per IS: 7310 (Part 1) 1974, & IS 7307					
Welding Parameters and technique:							
Sl. Sequence No.	Welding Parameters		Arc Voltage (Volt)	Wire Feed Speed (m/min)	Travel Speed (m/min)	Electrode Stick out (mm)	Gas Flow (L/min.)
	Electrodes wire dia. (mm)	Current (Amps)					
1	3.15	140-180	24-26	N.A.	N.A.	N.A.	N.A.
Provision of run-on / run-off tabs		: N.A.					
Cleaning of weld bead before laying next weld bead		: N.A.					
Root preparation before welding other side of groove weld		: N.A.					
Preheating and inter pass temperature		: N.A.					
Peening		: Not Required					
Post Weld treatment		: Not Required					
Rectification of weld defect		: By re-welding after complete removal of defect by grinding as per IS 9595-96 Cl. 32.2, using A2 Class of electrodes of Specn. IRS M.28-02, after conducting D.P. Test.					
Inspection of Weld		: Visual.					
Any other relevant Details with acceptance level		: IRS-B1, IRC-24, IS-7307, IS-7310, IS-9595, IS 816					